

Name T. Keith Butters

Service No. 61

Address 52 Meriam Street

52 Meriam St.

Location

Kind of Pipe

Size

Size of Main

~~Repair~~—Renewal—~~New Service~~ NO #4725

Location OCT 25 1976


Date	Material	Amount	Total	Date	Amount
7/21/76	labor	48. 27		7/19-76	150 00
	10%OH	4. 83	53. 10	10/15/76	59 89
4½'	6" Transitee pipe		6. 66		90 91
½	bag cement		. 82		
1	4" to 6" gasket		3. 05		
½	hr. trucking @ 3.00		1. 50		
½	hr. compressor @ 5.00		2. 50		
	Patch 5 X 5		16. 62		
	Patch 2 X 5		6. 66		
			90. 91		

DATE _____

TOWN OF LEXINGTON — BOARD OF PUBLIC WORKS
SEWER DIVISION

52

Sketch of Service Here

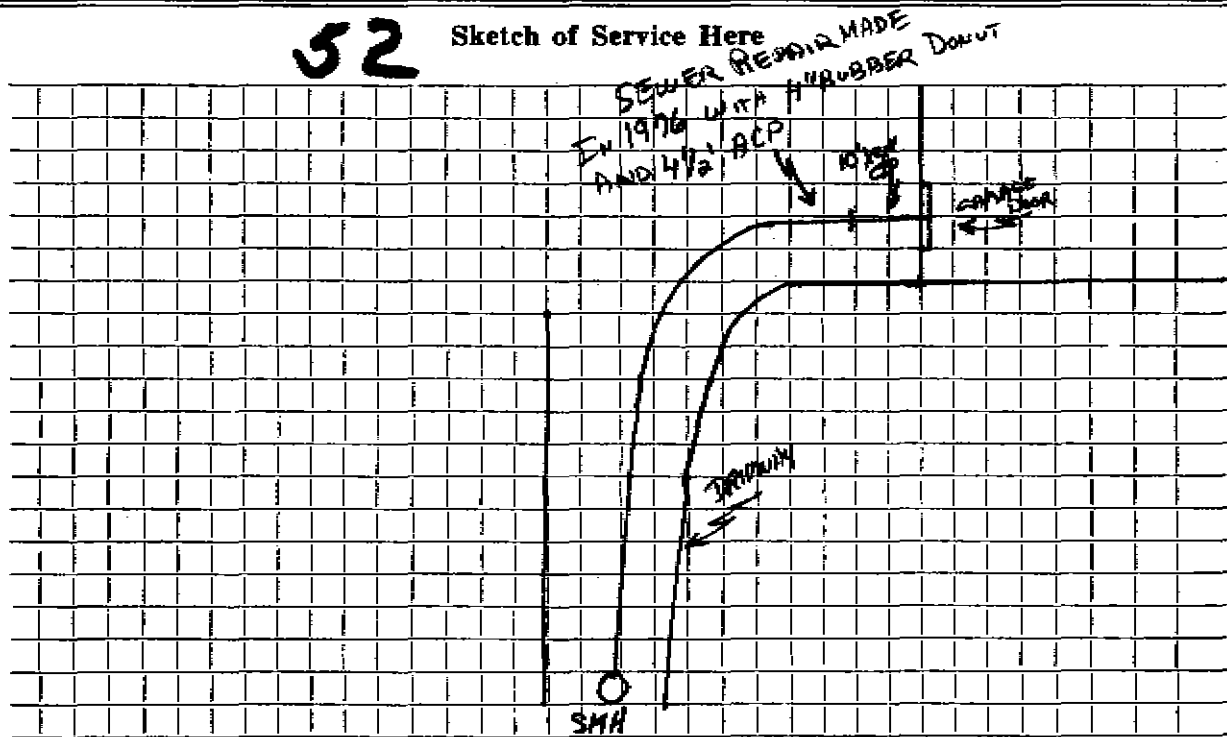

Connection made in Street. Work completed

Remarks: Original Service (90'-6" Sewer Pipe) 12-15-55