


DATE 21 JUNE 1995

TOWN OF LEXINGTON — BOARD OF PUBLIC WORKS
SEWER DIVISION

Sketch of Service Here 55

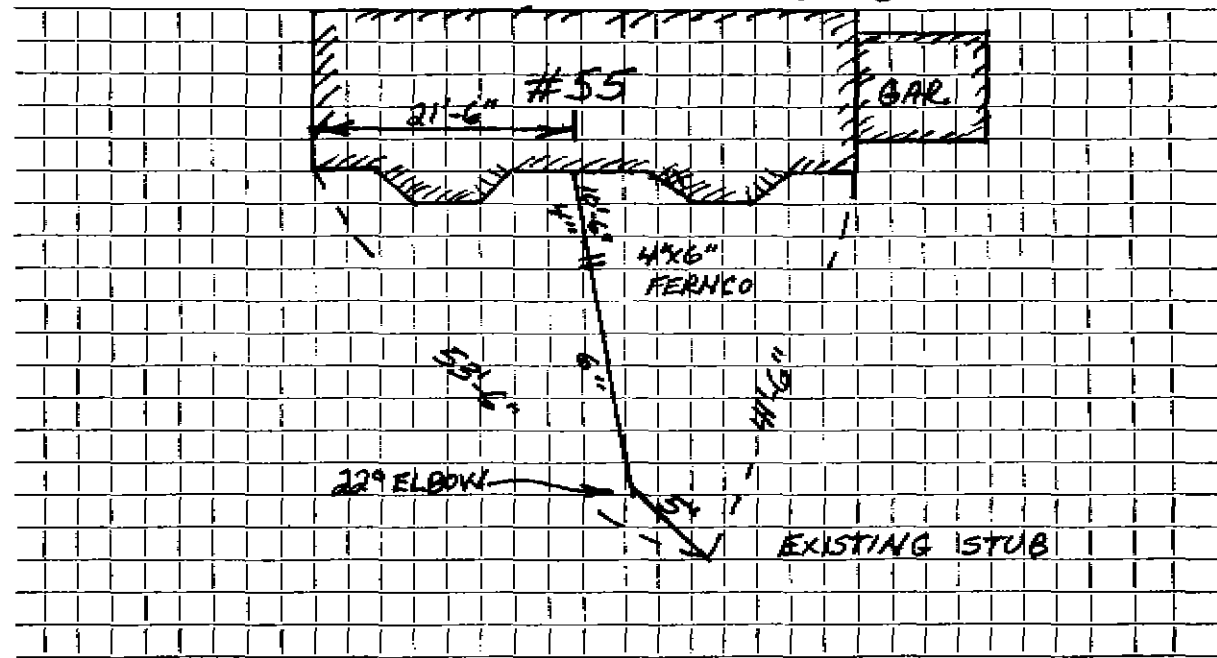

Connection made in MERIAM STREET Street.

Work completed J.M. MCLAUGHLIN

Remarks: