

Name Jack Butler

Service No. 29

Address # 57 MERRIAM ST

57 Meriam ST.

Location

Kind of Pipe ACP

Size 6"

Size of Main 8"

~~Repair~~ New Service Valer1 #3717

Location SEP 21 1981

Date	Material	Amount	Total	Date	Amount
<del>7-2-80</del>	<del>30' of 6" ACP @</del>	<del>\$14.00/FT</del>	<del>\$420.00</del>	<del>8-14-81</del>	<del>Deposit</del>
1/19/81	29' 6" P.V.C.				420.00
	150' 5" C.I.P.			9-2-80	
				30' 6" Transite	
				1 6" Transite - 6" P.V.C. Fernco	
				1 6" X 8" Wye	


DATE \_\_\_\_\_

TOWN OF LEXINGTON — BOARD OF PUBLIC WORKS

SEWER DIVISION

Sketch of Service Here

57

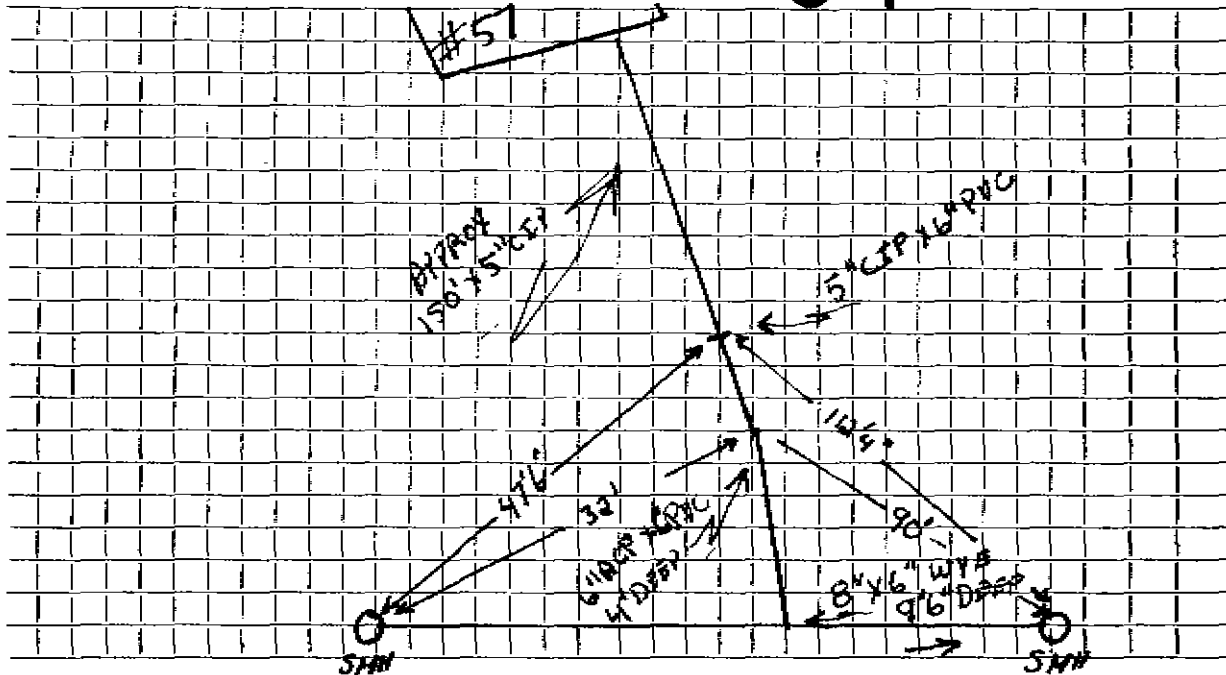

Connection made in ..... Street. Work completed .....

Remarks: .....

.....

.....