

Name Martin Schilling

Service No. 30

Address 66 Meriam Street

66 Meriam ST.

Location Lot 24

Kind of Pipe

Size

Size of Main


Repair—Renewal—New Service Eagle #1598

Location JUL 27 1970

Date	Material	Amount	Total	Date	Amount
69	26' 8" Transite pipe @10.00= 260.00 COST TO BE SPLIT WITH #68	260.00	130.00	5-19-70	Deposit 130.00
20-70	18' 6" Transite pipe				
	5' 4" Cast Iron pipe				
	100' 8" Transite pipe (split with #68)				

TOWN OF LEXINGTON — BOARD OF PUBLIC WORKS

SEWER DIVISION

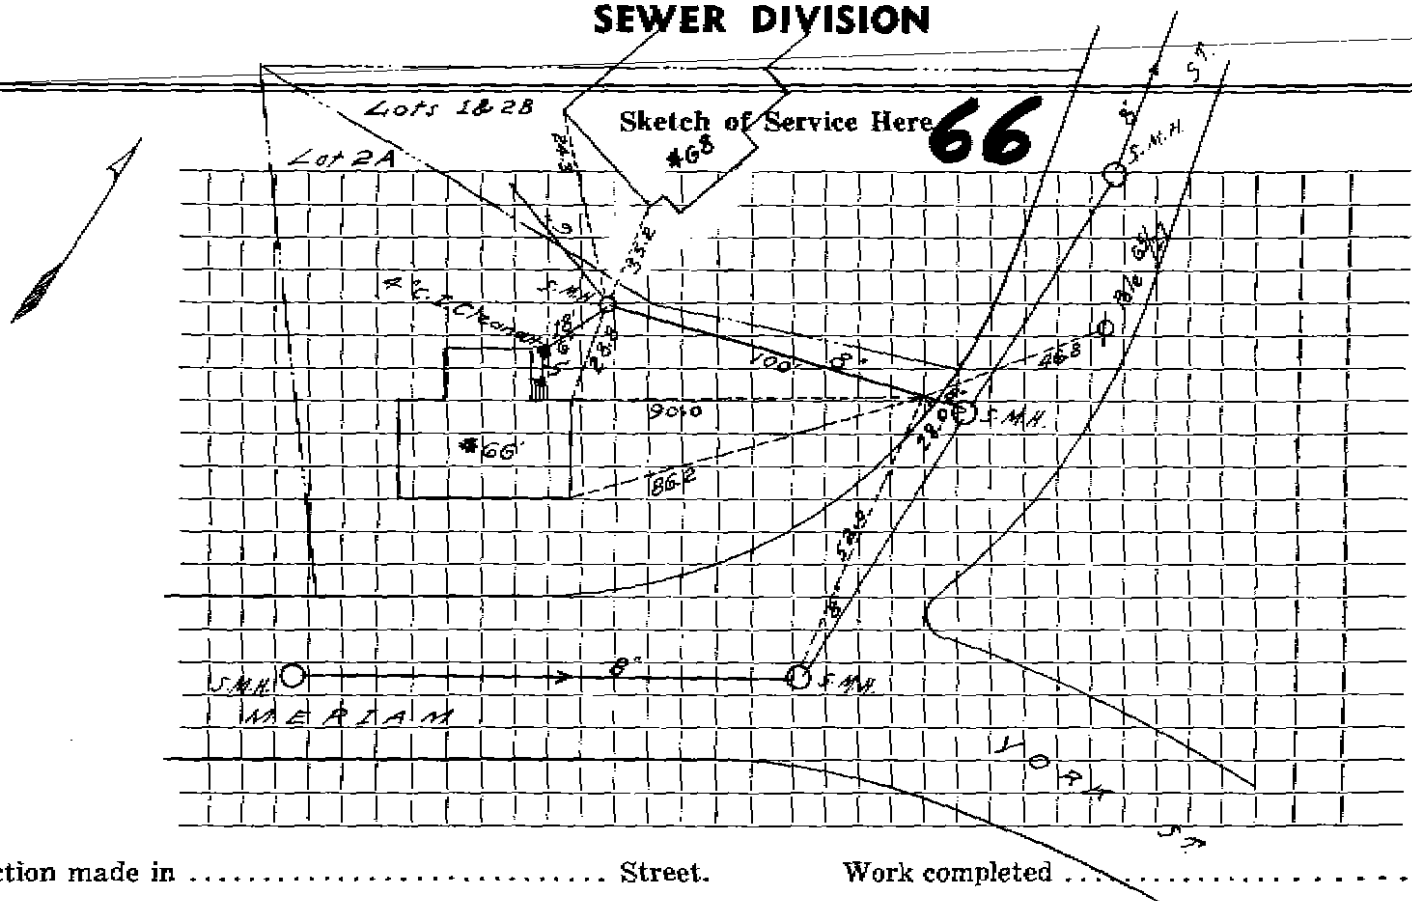

Connection made in ..... Street. Work completed .....

Remarks: .....  
.....  
.....