

Name Ted Freeman

Service No. 152 (75)

Address 76 Meriam Street

Lot Vacant Lot 35

Location 71 Meriam ST.

Kind of Pipe

Size 6"

Size of Main 8"

Repair—Renewal—New Service Eagle #2788


Location AUG 16 1976

Date	Material	Amount	Total	Date	Amount
<del>1969-17</del>	<del>6" Transite Pipe</del>	@10.00	170 00	12-4-5	Deposit 170 00
26/76	55' 6" Transite Pipe				
	10' 4" Cast Iron Pipe			'69'	
				17' 6" Transite	
				1 6"x8" Wye	

DATE \_\_\_\_\_

TOWN OF LEXINGTON — BOARD OF PUBLIC WORKS

SEWER DIVISION

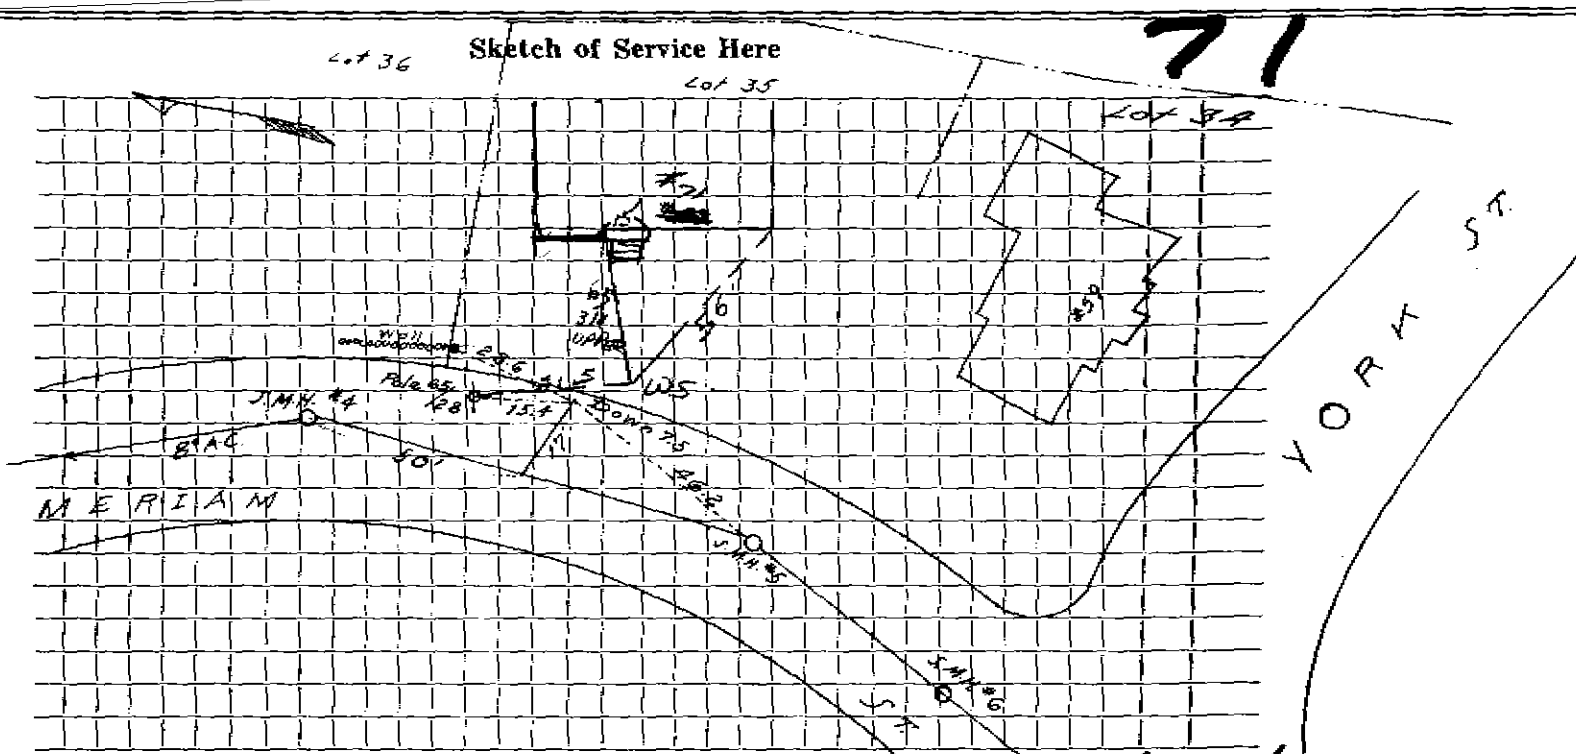

Connection made in #71 Meriam St. Street.

Work completed .....

3/26/78

Remarks: .....  
.....  
.....