

Name GRISCOM

Service No.

Address 72 MERIAM STREET

Location

Kind of Pipe P.V.C.

Size 6"

Size of Main

Repair—Renewal—(New Service) - PERMIT N° 1003

Location


Date	Material	Amount	Total	Date	Amount
SEPT 8 97	32' P.V.C PIPE				
	1 CLEAN OUT				
	2 FERRULES				

DATE _____

TOWN OF LEXINGTON — BOARD OF PUBLIC WORKS

SEWER DIVISION

Sketch of Service Here **72**

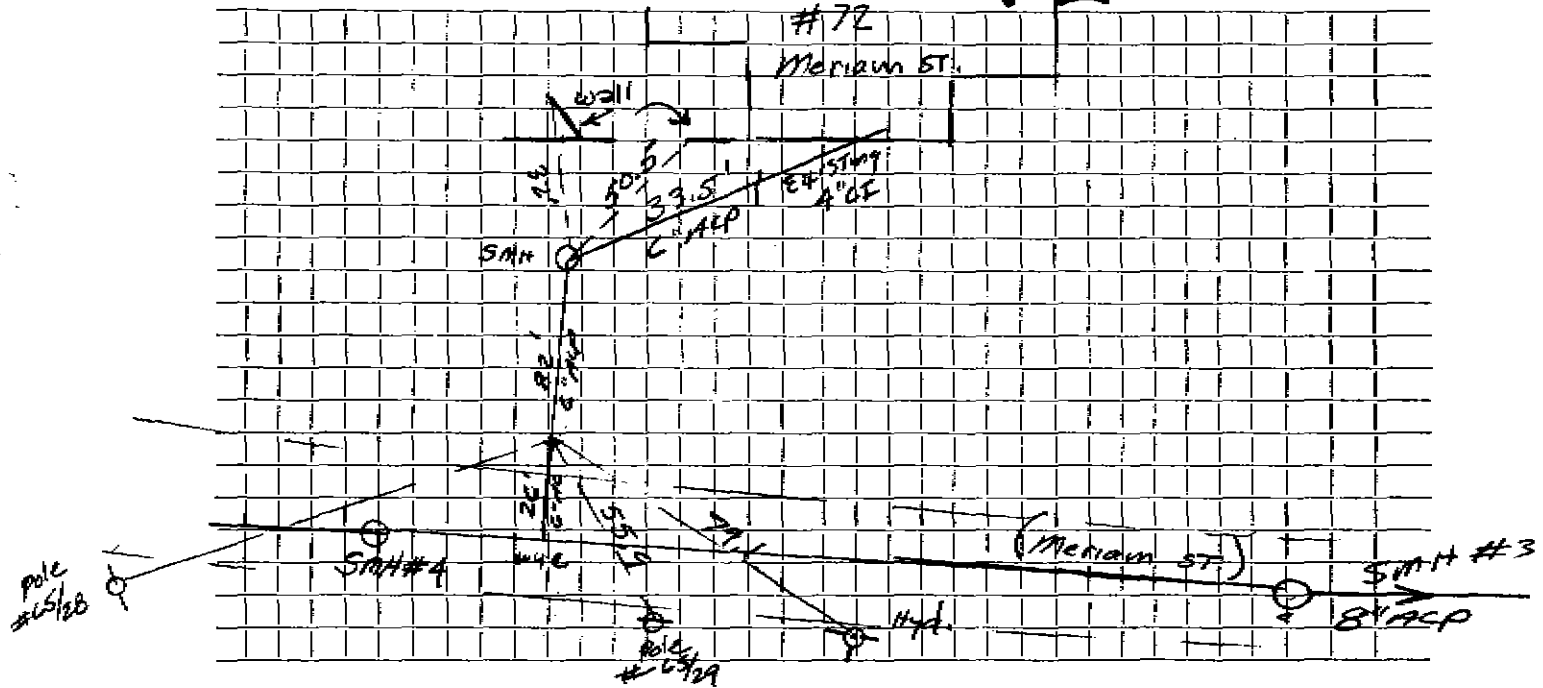


Connection made in Street. Work completed

Remarks:

DATE SEPT 8 1997

TOWN OF LEXINGTON — BOARD OF PUBLIC WORKS

SEWER DIVISION

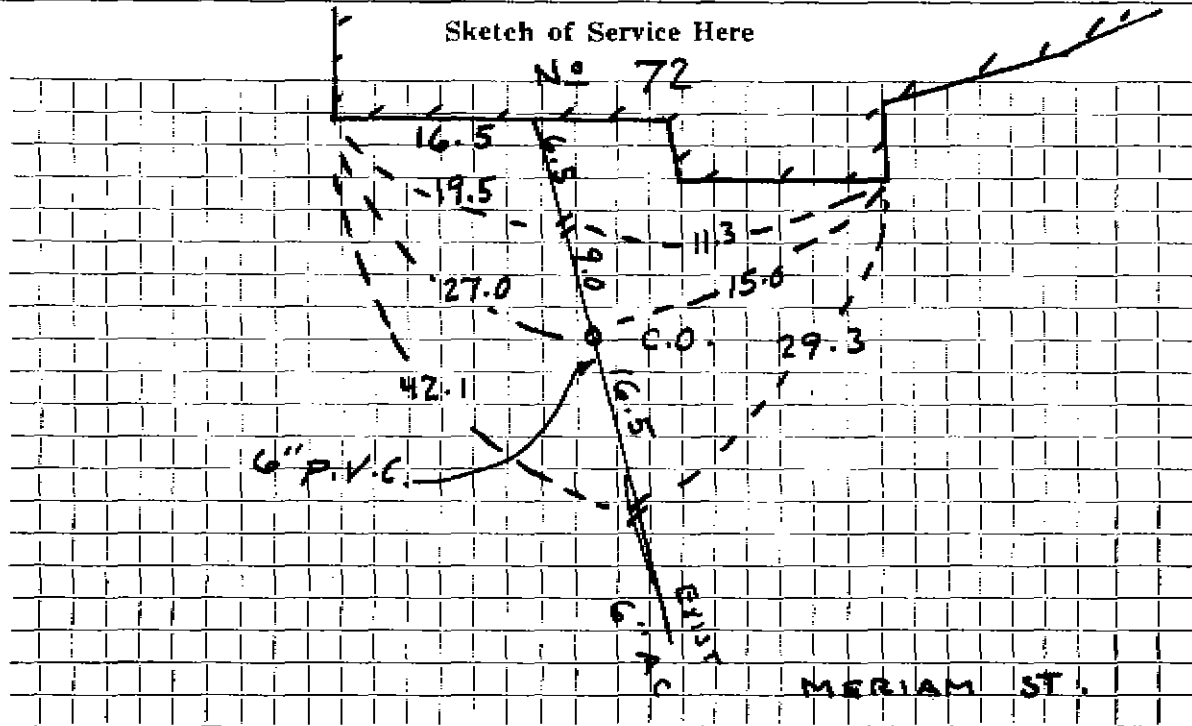

Connection made in MERIAM Street. Work completed I.M. McLAUGHLIN

Remarks:


FIELD NOTE BOOK 97-5

TJM

DATE SEPT 8 1997

TOWN OF LEXINGTON — BOARD OF PUBLIC WORKS

SEWER DIVISION

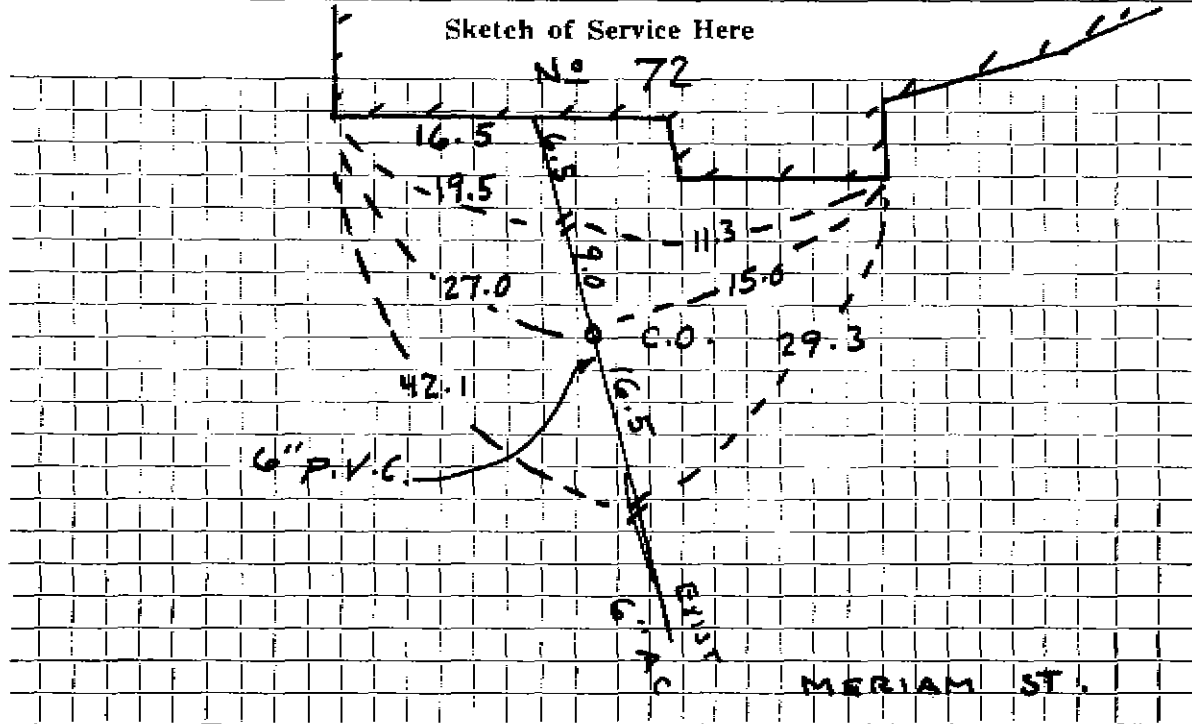

Connection made in MERIAM Street. Work completed I.M. McLAUGHLIN

Remarks:

FIELD NOTE BOOK 97-5

TJM