


DATE 12-16-82

TOWN OF LEXINGTON — BOARD OF PUBLIC WORKS

SEWER DIVISION

Sketch of Service Here

87

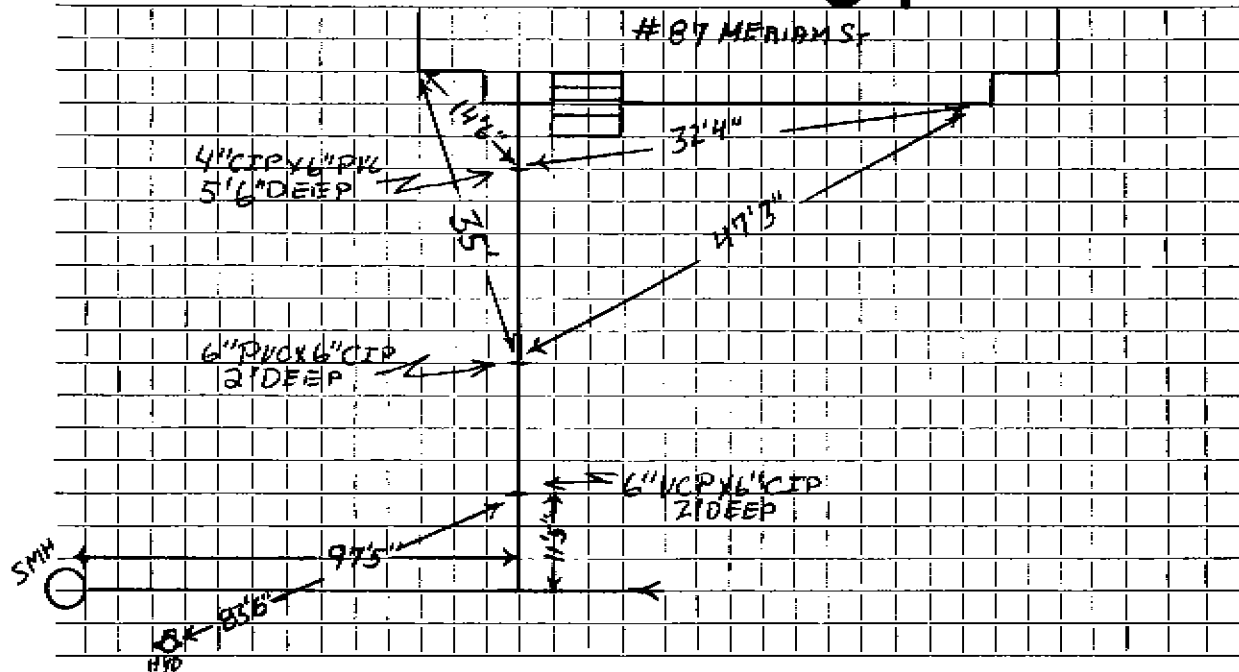

Connection made in MERIDIAN ST Street. Work completed

Remarks:
.....
.....