

Name Edward H. Mara

Service No. 19 927

Address 9-11 Meriam St.

Location

Kind of Pipe

Size

Size of Main

~~Repair - Renewal~~ - New Service

Location

Date	Material	Amount	Total	Date	Amount
24-10-28 for 170.71	130' 6" Sewer Pipe @ .30	39 00		April 14, 1925 - Cash	170 71
	3 6x6 Y'S @ 1.05	3 15			
	3 6" Plugs @ .12	36			
	1 6"x $\frac{1}{2}$ " Bend	70			
	Sulphur & Jute	5 20			
	Trucking	2 75	51 16		
10/26/28	54 Hrs. Labor @ .55	29 70			
	8 ² " " @ .70	6 06			
	6 " " @ .60	3 60			
10/27/28	97 " " @ .55	53 35			
	8 ² " " @ .60	5 20			
	8 ² " " @ .70	6 06	103 97		
	15% Overhead Labor		15 58		
			170 71 ✓		
1-25-52	New Service				
	20' 6" Sewer Pipe				

TOWN OF LEXINGTON - BOARD OF PUBLIC WORKS

SEWER DIVISION

DATE 3/21/28

NO. 19


The undersigned applies for the construction of a particular sewer connecting No. Merriman St. Street and hereby agrees to comply with the Rules and Regulations governing the construction and use of Particular Sewers, as now or at any future time established by the Board of Selectmen.

Am't. of Estimate \$ 250⁰⁰

Am't. Paid \$ _____

Edward H. Mearns Owner

Sketch of Service Here **11**

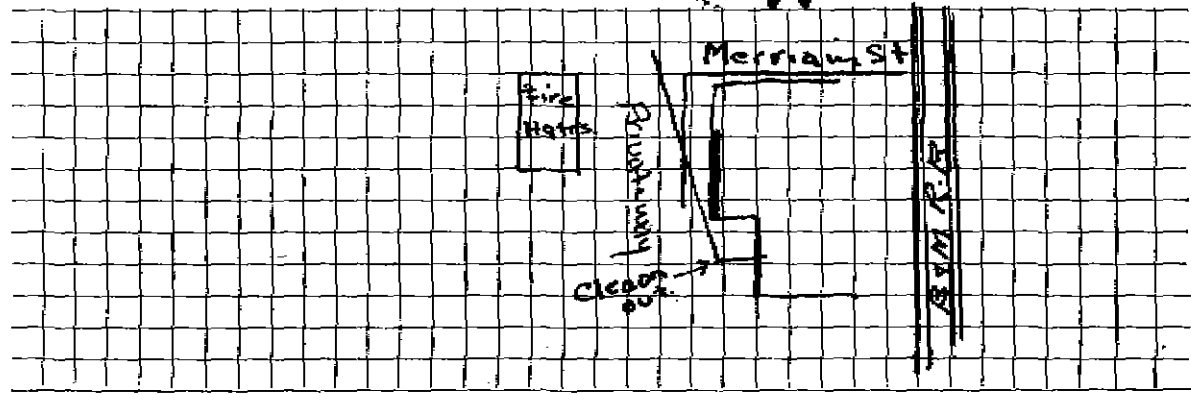

Connection made in _____ Street.

Work completed _____ 19

Remarks: