

Name Moore Homes, Inc.

Service No. 112

Address 9 Meriam Street

9 Meriam ST.

Location

Kind of Pipe

Size 6"

Size of Main 8"

~~Repair~~ Renewal New Service DeFlite #A414
Dott #3077

Location SEP 5 1967


Date			Material		Amount	Total	Date	Amount
							8-7-66	
12/66		Labor	8.	20			<i>Deposit</i>	350 00
		10% O.H.		.82	9.	02	<i>Refund</i>	214 25
		1 8 x 6 Saddle			9.	50		35 97
		1 6" Solid Sleeve			14.	45		
		1 Hr. Trucking			3.	00		
					35.	97		
1/67	8'	6" Cast Iron Pipe						
							<i>Apply 29.55 to SALES TAX</i>	
							<i>Apply 21.45 to INTEREST</i>	

DATE _____

TOWN OF LEXINGTON — BOARD OF PUBLIC WORKS
SEWER DIVISION

Sketch of Service Here

9

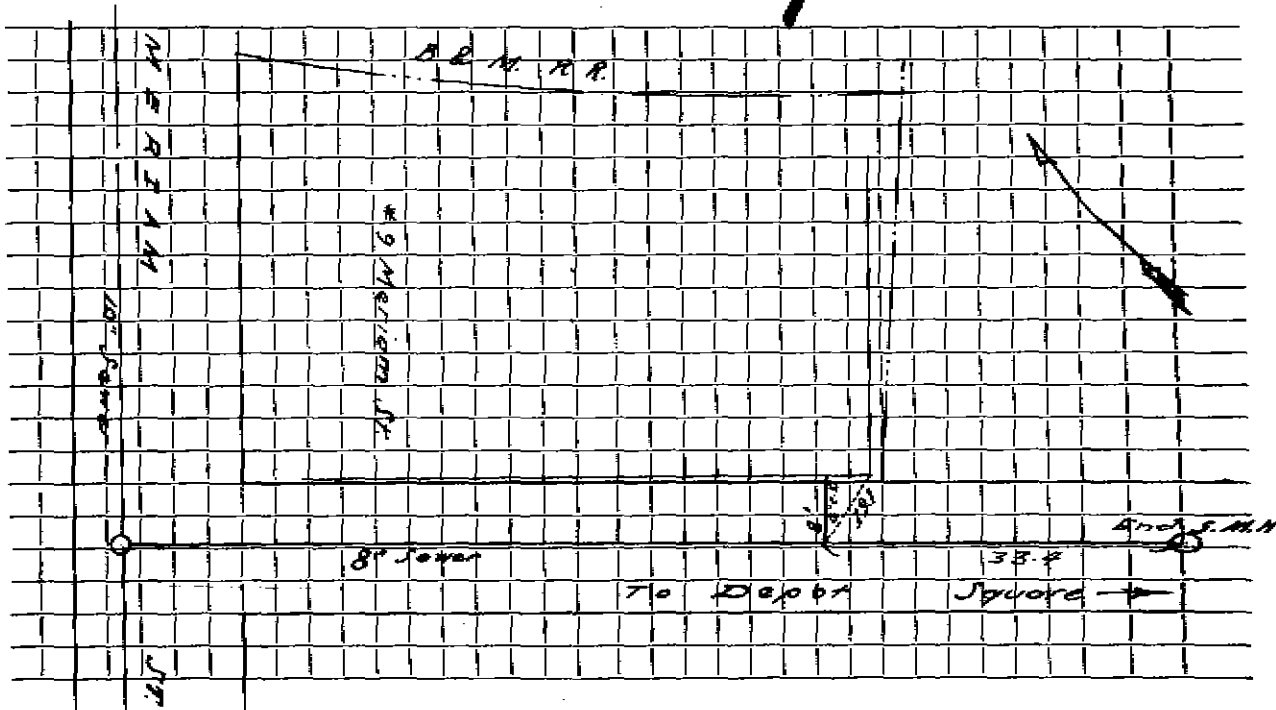

Connection made in Street. Work completed

Remarks:

.....

.....