

Name Henry Latimer Seaver

Service No. 30

Address 95 Meriam Street

95 Meriam ST.

Location

Kind of Pipe

Size 6"

Size of Main 8"

Repair—Renewal—New Service

W.C.#4522 Lexington Sewerage #530

Location


JAN 22, 1968

Date	Material	Amount	Total	Date	Amount	
-11-67	80' 6" Transite pipe			5-1-67	Deposit	235.00
	15' 4" Cast Iron pipe			2/15/68	Paid	14.81
10/67	Labor	68.52				239.81
5-67	"	24.36		7-5-67		
5-67	"	11.65	104.53	20'	6" Transite	
	10% O.H.	10.45	114.98	1	6" Elbow	
	20' 6" Transite pipe @.88		17.60	1	6" Nipple	
	1 Elbow		4.09	1	6" 8" Saddle	
	1 6" Nipple		.91	6'	8" Clay Pipe	
	1 Saddle		5.50			
	1½ Bag Cement @1.15		2.63			
	6' 8" Clay pipe @.70		4.20			
	3 ton Hot top @.580		17.40			
	9 hrs. Trucking @3.00		27.00			
	4 hrs. Shovel @6.50		26.00			
	2 hrs. Loader @4.00		8.00			
	½ hrs. Roller @1.00		1.50			
	2 hrs. Compressor		10.00			
			239.81			

DATE _____

TOWN OF LEXINGTON — BOARD OF PUBLIC WORKS

SEWER DIVISION

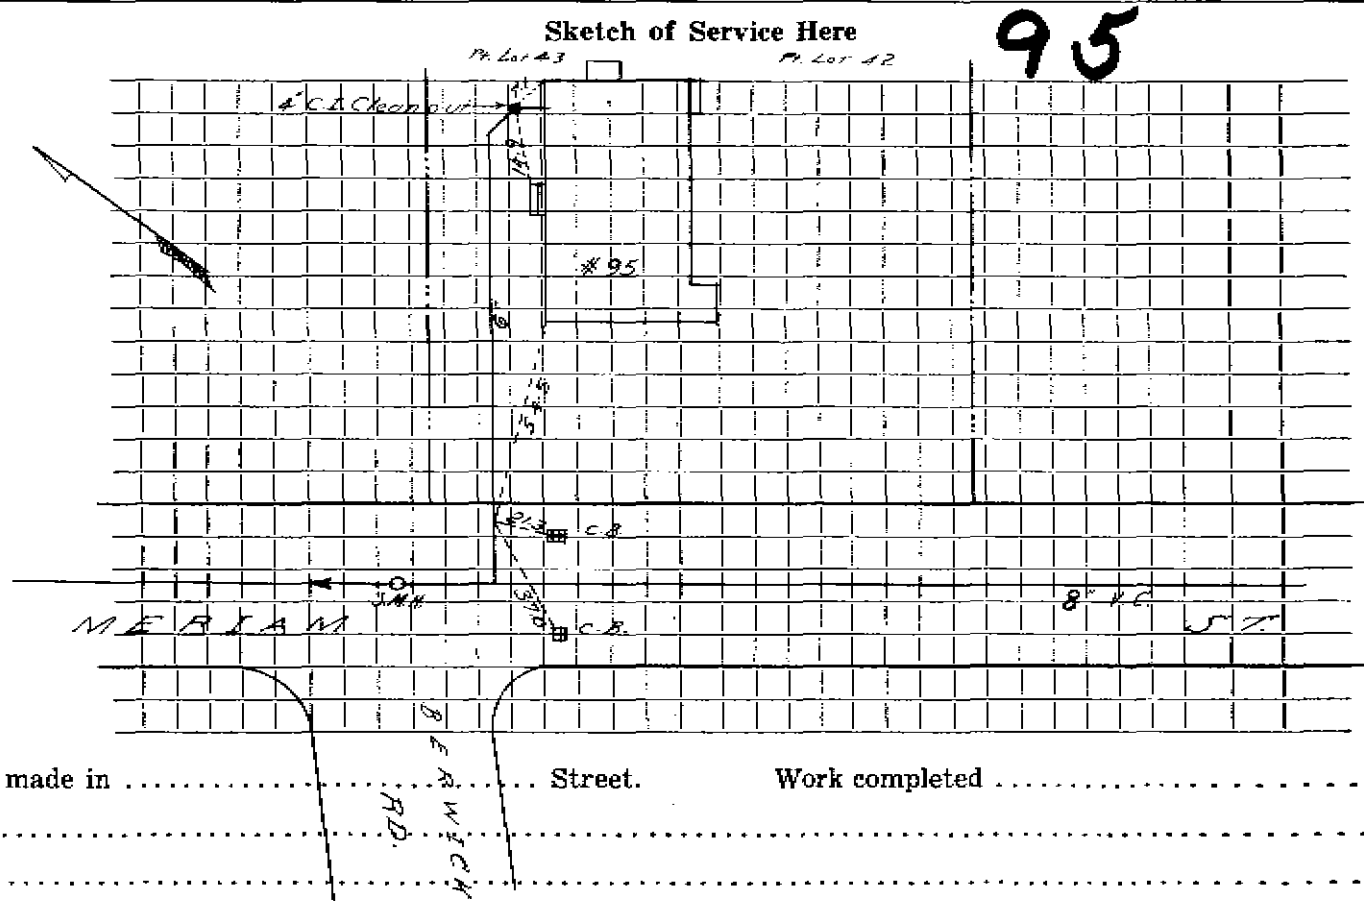

Connection made in Street. Work completed

Remarks:

.....

.....