

Name Charles P. Whittimore

Service No. 112

Address 96 Meriam Street

96 Meriam ST.

Location

Kind of Pipe

Size 6"

Size of Main 8"

~~Repair~~ Renewal ~~New Service~~ W.O. #5441

Location AUG 5 1968


Date	Material	Amount	Total	Date	Amount	
1/12/67	Labor	102.48		9-13-67	Deposit	200 00
1/24-26/67	"	159.92	262 40	9-15-68	Prod	187 80
	10% O.H.	26 24	288 64	5-18-55	26' 6" Sewer Pipe	382 80
78'	6" Transinte pipe @ .88		68 64			
2	11 1/2 Elbow @ 2.35		4 70			
1	11 1/2 Sweep		4 09			
1	Frame & Cover		10 50			
1	Ton Loam		3 50			
1/2	Lb. Seed		55			
1	90° Elbow		4 09			
6	Ton Hot top @ 5.80		34 80			
1/2	Ton cold patch @ 5.50		2 75			
4	Hrs. Trucking @ 3.00		12 00	1	Hr. Roller & trailer	5 00
2	Hrs. Loader @ 4.00		8 00	5	Hr. Shovel @ 6.50	32 50
1	Hr. Compressor		5 00			484 76
				PRO-RATED	484.76 X 20yrs =	387.80
				2-13-67	Roots	
				1-31-67	Roots	

DATE _____

TOWN OF LEXINGTON — BOARD OF PUBLIC WORKS

SEWER DIVISION

Sketch of Service Here

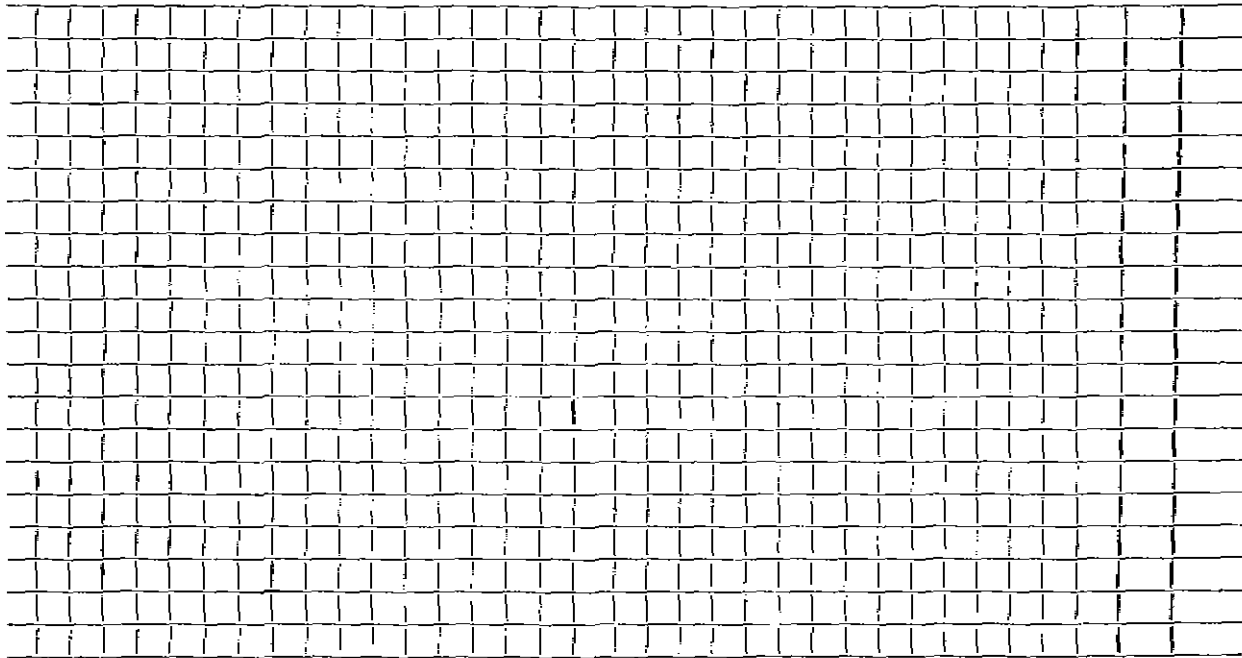

Connection made in Street Work completed

Remarks: Original Service 6-8-48 (78'-6" Sewer Pipe, 1-6" x 1/8" Bend, 1-6" Wye)

SERVICE COMES OUT IN DRIVEWAY ON JUNIPER
ROOTS IN M.H. CLEAN-OUTS