

Name RICHARD F. MAGNUSON

Service No. 109

Address 97 MERIAM STREET

97 Meriam ST.

Location

Kind of Pipe

Size 6"

Size of Main 8"

Repair—Renewal—New Service W.D. #5174


De felice
Permit No. 3264

Location May 9 1977

Date	Material	Amount	Total	Date	Amount
				12-27-76	DEPOSIT 250.00
2/15/76	Labor	79.44		5-9-77	Refund 37.14
	10% O.H.	7.94	87.38	12-15-76	212.86
	2 10'x6" Transite @ 17.50		35.00		22' 6" Transite
	+ 22 1/2' Transite band		11.10		1 6"-22 1/2" Bend
	1 6"x8" cast iron		20.42		1 6"x8" C.I. Saddle
	4'x15' Patch		39.96		
	2 hrs Trucking @ 3.00		6.00		
	2 hrs. Town shovel @ 6.50		13.00		
			212.86		
4/20/77	20' of 6" AC				
	20' of 4" CI				

TOWN OF LEXINGTON — BOARD OF PUBLIC WORKS
SEWER DIVISION

Sketch of Service Here **97**

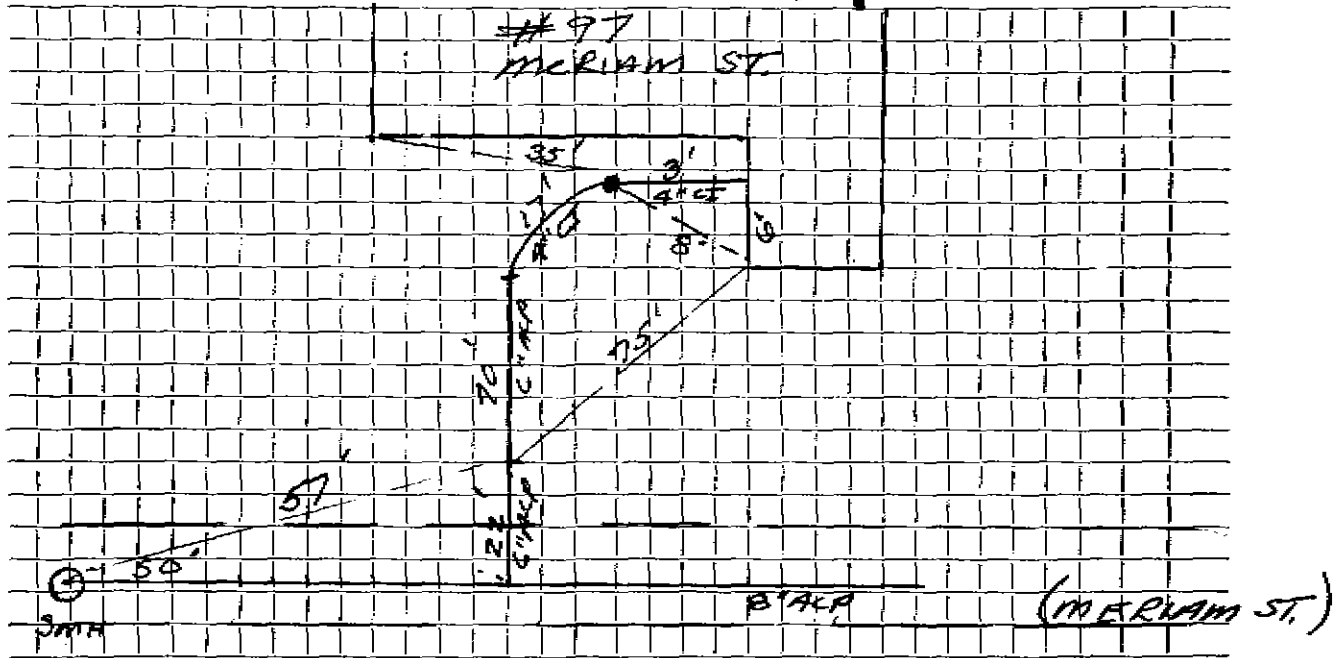

Connection made in Street. Work completed

Remarks:

.....

.....