

Name Arthur Heard

Service No. 165

Address 99 Meriam Street

Location W. O. 8284

99 Meriam ST.

Kind of Pipe

Size 6"

Size of Main 8"

~~Repair~~ ~~Renewal~~ ~~New Service~~ W O # 8284

Location MAR 23 1964


Date	Material	Amount	Total	Date	Amount
/20/63	Labor	37 04		11-4-63	250 00
/21/63	"	60 64		3-23-64	1 14
		97 68			251 14
	10% Overhead	9 77	107 45		
55'	6" Transite pipe @ .82		45 10		
1	90° Transite elbow		4 09		
	19 x 3 Patch		19 00		
7	yds. Loam @ 3.00		21 00		
7	hrs. Town shovel @ 6.50		45 50		
3	hrs. Trucking @ 3.00		9 00		
			251 14		

Deposit
Paid by W.O. # 1130

DATE _____

TOWN OF LEXINGTON — BOARD OF PUBLIC WORKS
SEWER DIVISION

Sketch of Service Here **99**

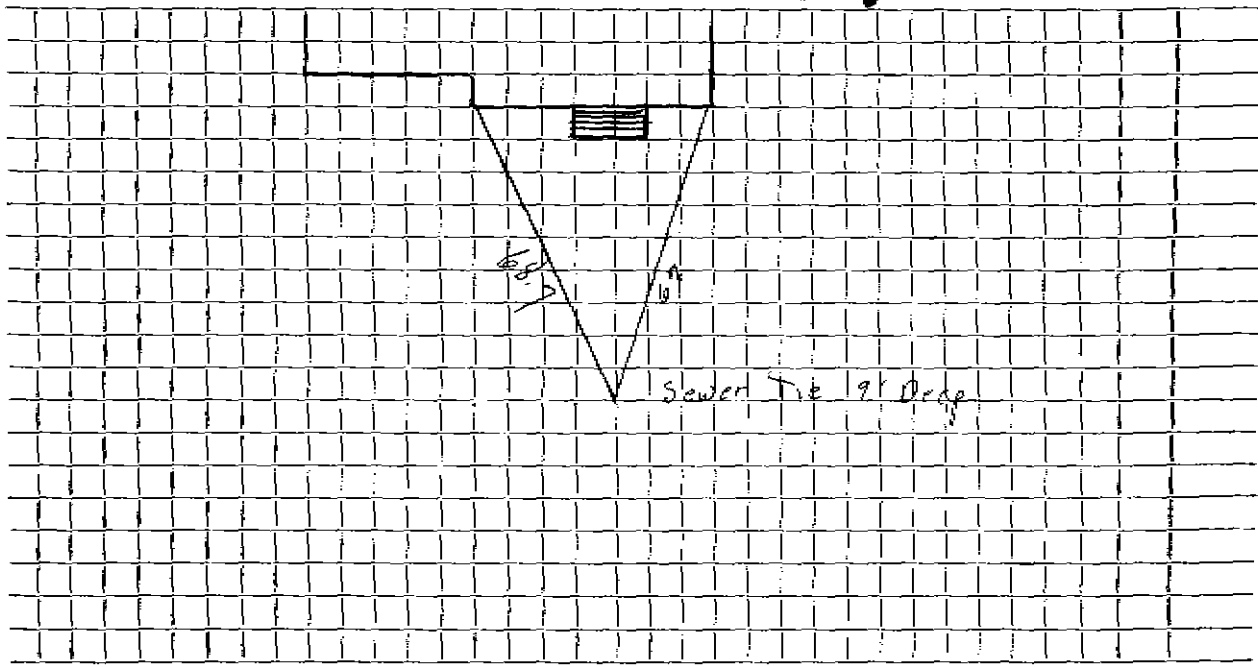

Connection made in Street. Work completed

Remarks:
.....
.....