

Name Raymond White

Service No. 82

Address 12 Middle St.

Lexington

Location 12 Middle ST.

Kind of Pipe

Size 6"

Size of Main 8"

Repair ~~Renewal~~ New Service

COM. 7-13-53

Location

Date	Material	Amount	Total	Date	Amount
5/22/53	Labor	22 17		5-4-53	Deposited 15000
5/23/53	Labor	47 17		7-13-53	Refunded 276
5/24/53	Labor	17 42			147 24
		86 76			
	10% overhead	8 68	95 44		
	46'-5" Transite Pipe @.55		25 30		
	2 Hr. Littlefield Shovel @7.50		15 00		
	2 Hr. Trucking @.75		1 50		
	Patching 10 x 3		10 00		
			147 24		
	Labor				

**TOWN OF LEXINGTON—DEPT. OF PUBLIC WORKS
SEWER DIVISION**

DATE.....

NO.


The undersigned applies for the construction of a particular sewer connecting No.....
Street and hereby agrees to comply with the Rules and Regulations governing the construction and use of Particular
Sewers, as now or at any future time established by the Board of Selectmen.

Am't of estimate \$.....

Am't Paid \$.....

..... Owner

Sketch of Service Here

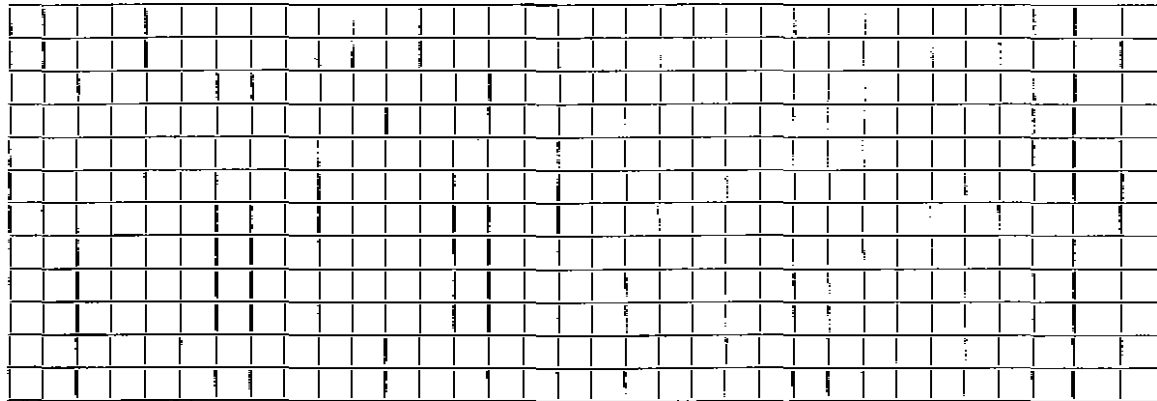

Connection made in Street: Work completed.....19..

Remarks: