

Name **Leo W. Kritsick**Service No. **60**Address **3 Middle Street**

(STATE PERMIT NEEDED)

3 Middle ST.

Location

Kind of Pipe

Size **6"**Size of Main **8"**~~REPAIR WORK~~ **New Service Valeri permit #2081**Location **AUG 14 1972**


Date	Material	Amount	Total	Date	Amount
2/54	Labor	21.97		5-4-72	53.61
	10% Overhead	2.20	24.17		
	10' of 6" Sewer Pipe @ .3087		3.09	5-12-54	
	Joint Compound		.60	10' 6" Sewer Pipe	
	1 hr. Town Shovel		5.00		
	1 hr. Trucking		.75		
	Patching 20 x 3		20.00		
			53.61		
2/72	67' Transite				
	10' 4" Cast Iron				

DATE _____

TOWN OF LEXINGTON — BOARD OF PUBLIC WORKS

SEWER DIVISION

Sketch of Service Here **3**

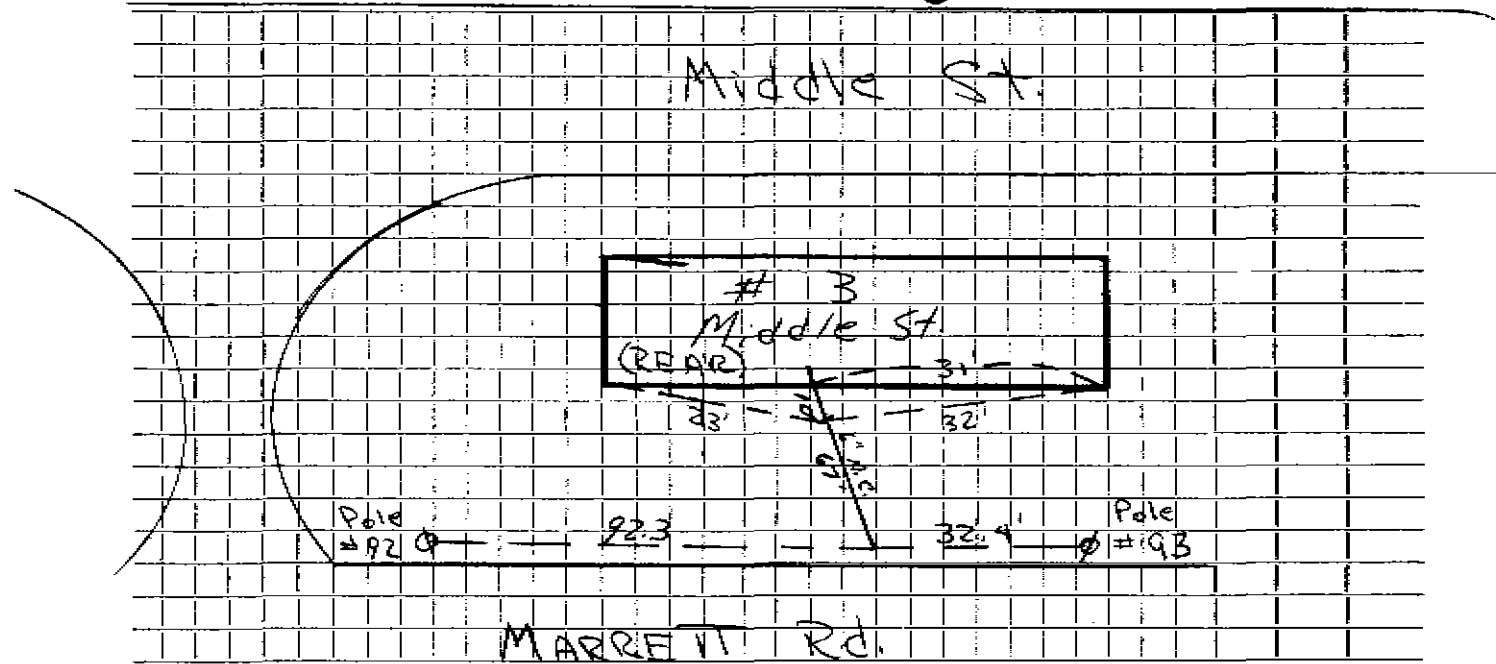

Connection made in Street. Work completed

Remarks:
.....
.....