

Name Pilgrim Developers Inc.

Service No. 34

Address 5 Middle Street

5 Middle ST.

Location

Kind of Pipe

Size

Size of Main

~~Repaired~~ ~~Revised~~ — New Service Eagle #1858
W.O. # 9569

Location JUL 26 1971

Date	Material	Amount	Total	Date	Amount
5/24/71	Labor	141 18		5-21-71	Deposit 240 00
5/27/71	"	20 30		7-26-71	Paid by W.H.C.#11 26 30
5/28/71	"	28 91	190 39	2-15-80	Paid 38 30
	10% O.H.		19 04		345 14
20'	6" Transite pipe .90		18 00		See W.O. 9569
1	6x6" Nipple		1 28	1/2	Yd. Loam 3.50 1 75
1/2	Bag cement 1.90		48		6'x8" Clay pipe .70 4 20
1	6" Plug		2 26	1	Bag cement 1 90
2	Ton Cold Patch 8.00		16 00		Labor 47 06
2	Ton Hot Top 7.45		14 90	1/2	Hr. Truck 3.00 1 50
4	Hrs. Trucking 3.00		12 00	1/2	Hr. shovel 4.00 2 00
1	" "		1 50		
2 1/2	Hrs. Shovel @ 6.50		16 25		
	" Compressor		5 00		
1	" Loader		5 00		
1/2	" Roller 2.00		1 00	11-29-75	Decrease Paper 74' Road
	Trailer		2 00		MH on Market Rd
-4-71	28' 6" Transite pipe		305 10		
	10' 4" Cast Iron pipe				


DATE _____

TOWN OF LEXINGTON — BOARD OF PUBLIC WORKS

SEWER DIVISION

Sketch of Service Here

5

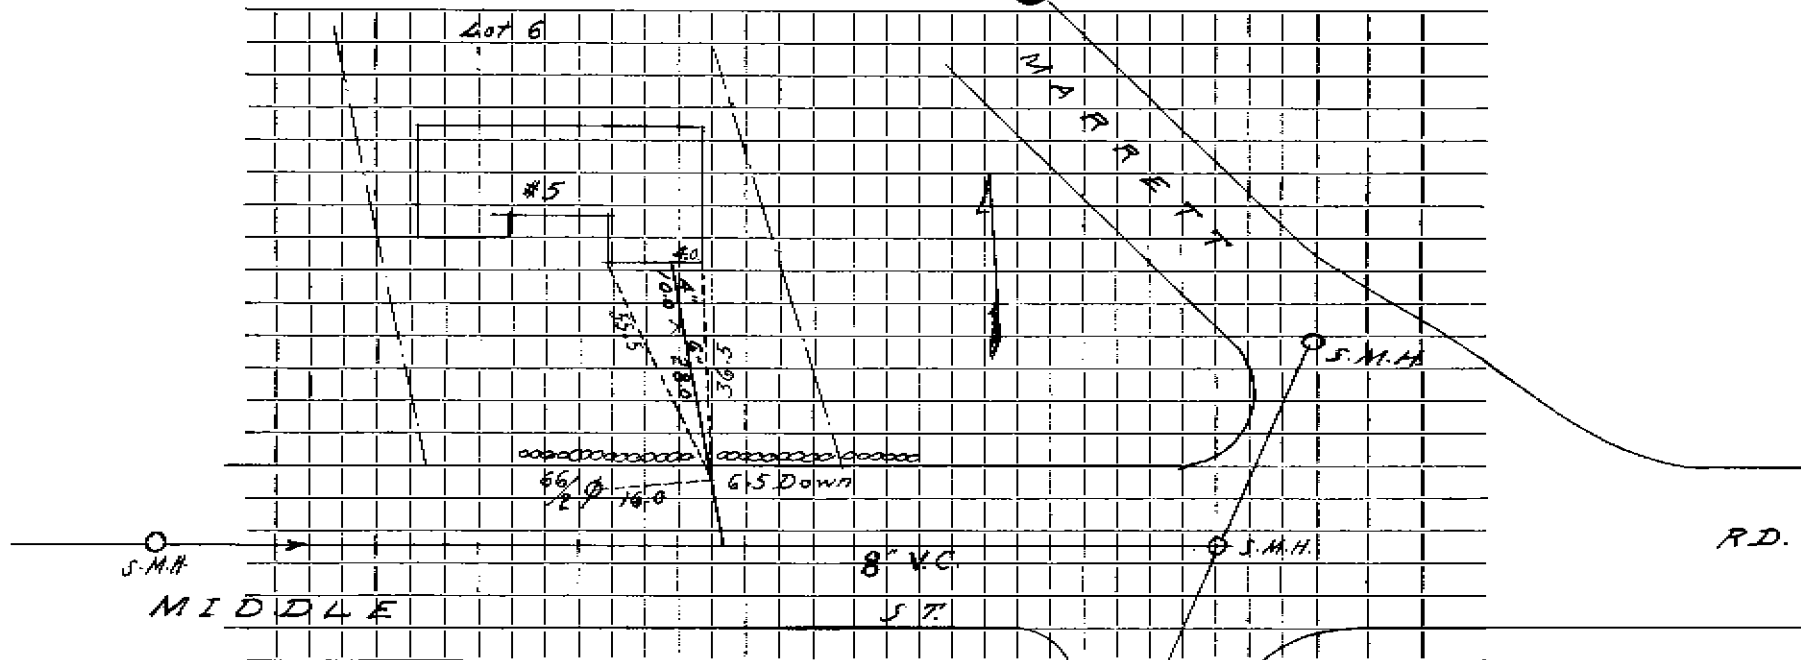

Connection made in Street. Work completed

Remarks:

.....

.....

CARY AVE.

R.D.