

Name Jojen Realty Trust

Service No. 142

Address 9 Middle Street

9 Middle ST.

Location

Kind of Pipe

Size 6"

Size of Main 8"

Repair—Renewal—New Service W.O. #9201 Eagle #1818

Location

JUL 26 1971


Date	Material	Amount	Total	Date	Amount
2/24/70	Labor	20.14		11-24-70	240.00
3/17/71	"	59.44		7-24-71	21.41
3/17/71	"	130.33	209.91		
	10% O.H.	20.99	230.90	2-24-70	
	48' 6" Transite pipe @.90		16.20		18' 6" Transite
	1 11" Elbow		3.95		1 6"-11" Elbow
	1 bag Cement @1.90		.48		1 6" X 8" Wye
	1 Plug		2.11		
	1 1/2 ton Cold Patch @8.00		12.00		
	2 1/2 ton Hot Top @7.45		18.63		
	Material & Equipment for blasting		111.00		
	7 hrs. Trucking @3.00		21.00		
	3 hrs. Compressor @5.00		15.00		
	6 1/2 hrs. Shovel @6.50		42.25		
	1 hr. Roller		2.00		
	1 hr. Trailer		2.00		
			477.52		
4-2-71	35' 6" Transite Pipe				
	10' 4" Cast Iron Pipe				
					Bill 214.4

DATE _____

TOWN OF LEXINGTON — BOARD OF PUBLIC WORKS

SEWER DIVISION

Sketch of Service Here **9**

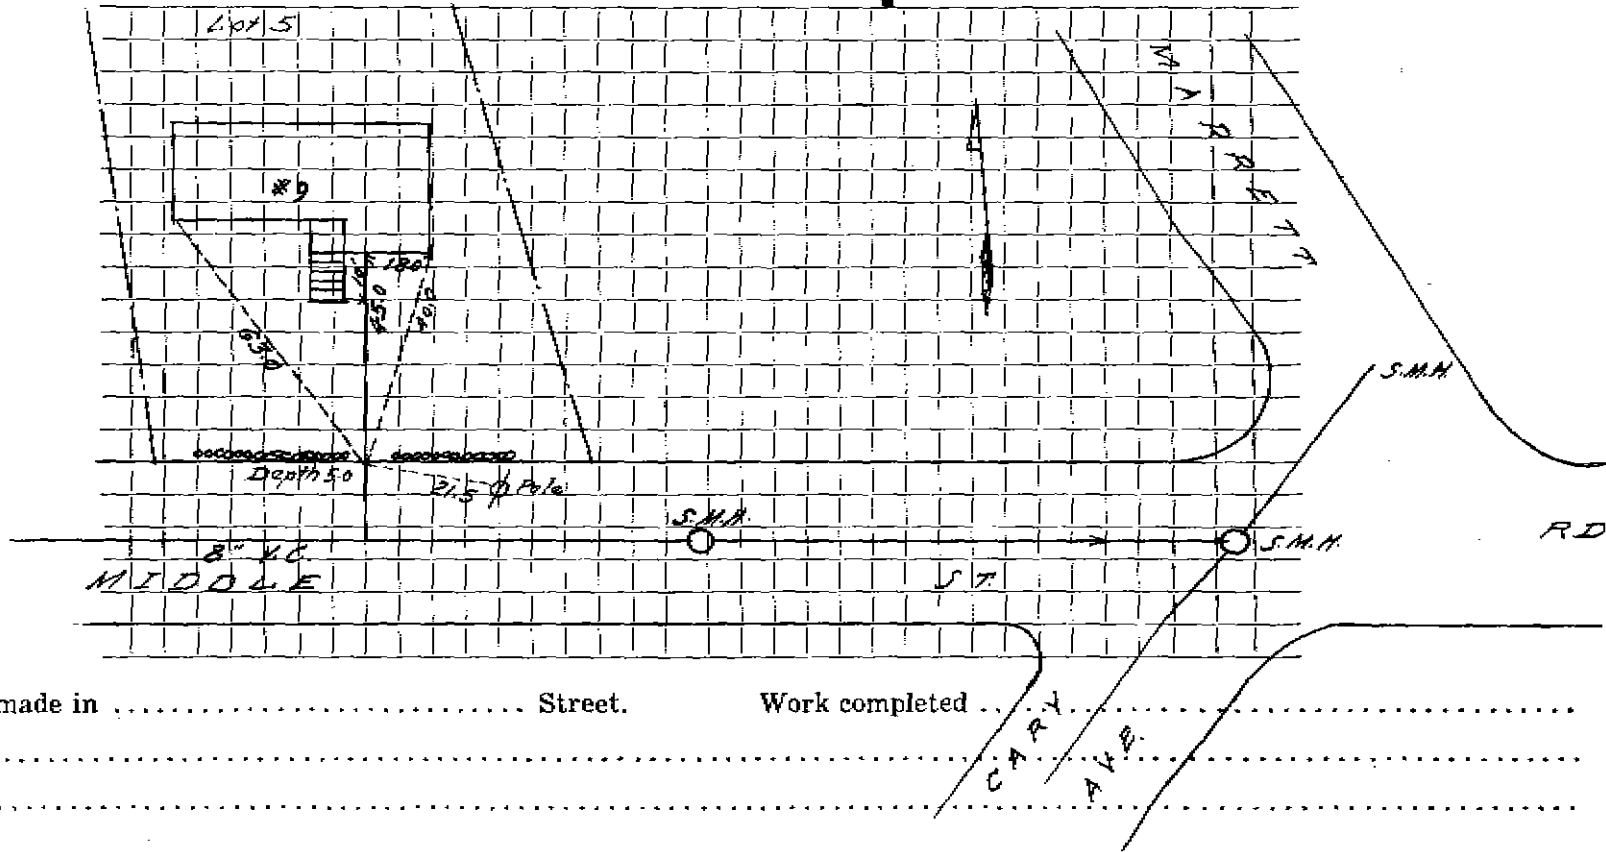

Connection made in Street. Work completed

Remarks:
.....
.....

**