

Name J. B. S. Holmes

Service No. 90

Address 14 Middle Street

14 Middle ST.

Location

Kind of Pipe

Size 6"

Size of Main 8"

Repair—Renewal—New Service W.O. #9824 Trebino #2105

Location AUG 14 1972

Date	Material	Amount	Total	Date	Amount
6-29-72	Labor 151.46	151.46		6-28-72	Deposit 150.00
7-7-72	" 31.72	<del>183.18</del>	183.18	10-2-72	Abated 62.91
	10% O.H.	<del>18.32</del>	<del>201.50</del>	10-13-72	Balance 83.01
10'	6" Transite pipe @.90	15.15	9.00		<u>233.01</u>
1	5' x 6" Nipple @.89		4.45		
1	2' x 6" Nipple		2.90		
1	6" Cap		2.55		
<del>1/2</del>	bag Cement @1.98		<del>.99</del>		
<del>3'</del>	12" R. C. Drain pipe @1.51		<del>4.53</del>		
<del>2</del>	ton Cold Patch @8.00		<del>16.00</del>		
1	ton Hot Top		8.00		
3 1/2	hrs. truck @3.00		10.50		
1 hr.	4 hrs. Shovel @6.50		<del>26.00</del>		
1	hr. Compressor		5.00		
1/2	hr. Loader @5.00		2.50		
1	hr. Roller @2.00		1.00		
1	hr. Trailer		1.00		
			<del>295.92</del>		
			233.01		


DATE \_\_\_\_\_

TOWN OF LEXINGTON — BOARD OF PUBLIC WORKS

SEWER DIVISION

Sketch of Service Here

14

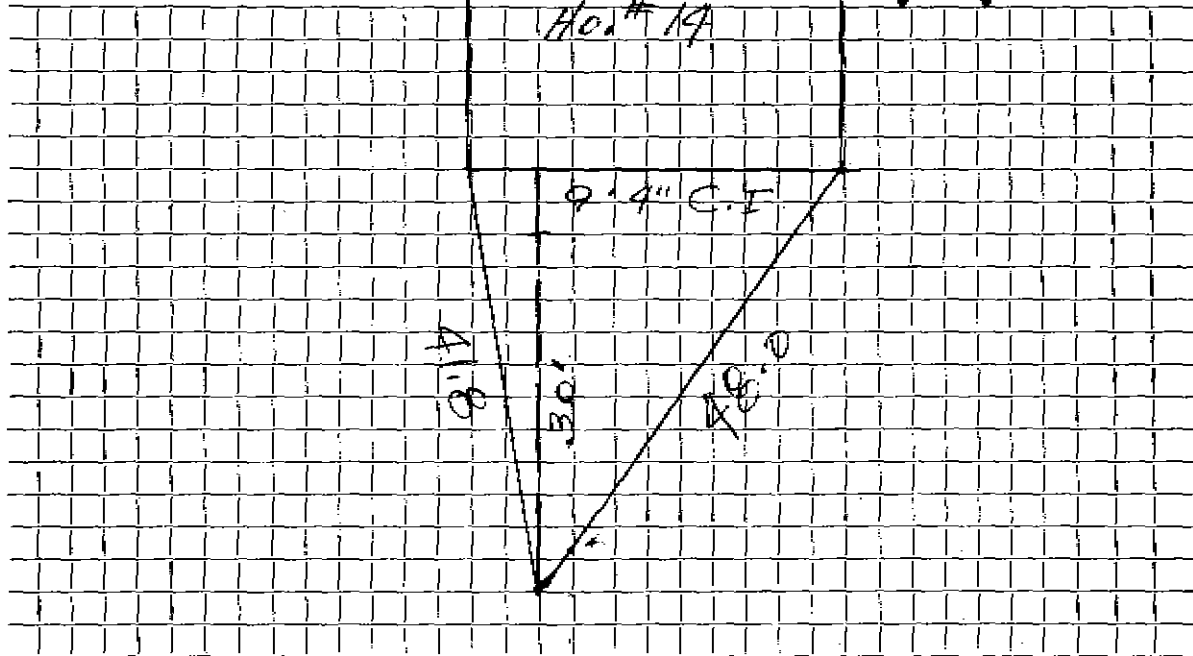

Connection made in ..... Street. Work completed .....

Remarks: .....

.....

.....