

Name James Clyde

Service No. 83

Address 16 Middle St.

16 Middle ST.
Lexington

Location

Kind of Pipe

Size 6"

Size of Main 8"

~~REMARKS~~ New Service

COM. 7-13-53

Location

Date	Material	Amount	Total	Date	Amount
5/17/53	Labor	25 00		3-4-53	Deposited 150 00
5/18/53	Labor	<u>54 17</u>		7-13-53	Refunded 10 95
		79 17			139 05
	10% overhead	7 92	87 09		
	40'-6" Sewer Pipe @.342		13 68		
	1-6" Elbow		1 88		
	Joint Compound		2 40		
	3 Hr. Littlefield Shovel @7.50		22 50		
	2 Hr. Trucking @.75		1 50		
	Patching 10 x 3		<u>10 00</u>		
			139 05		
	Labor				

TOWN OF LEXINGTON—DEPT. OF PUBLIC WORKS
SEWER DIVISION

DATE.....

NO.


The undersigned applies for the construction of a particular sewer connecting No.....
Street and hereby agrees to comply with the Rules and Regulations governing the construction and use of Particular
Sewers, as now or at any future time established by the Board of Selectmen.

Am't of estimate \$.....

Am't Paid \$.....

..... Owner

Sketch of Service Here

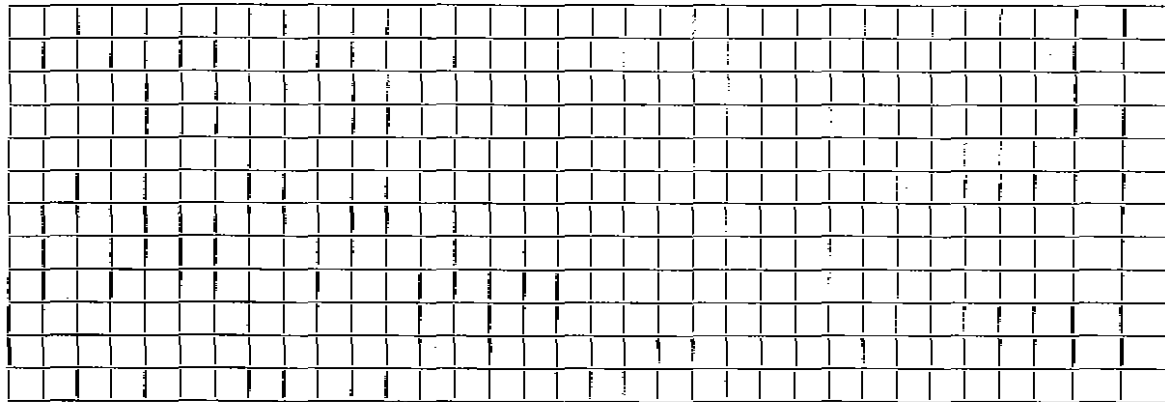

Connection made in..... Street.

Work completed..... 19..

Remarks: