

Name Malcolm R. Scott

Service No. 61

Address 18 Middle St.

18 Middle ST.

Location

Kind of Pipe

Size 6"

Size of Main 8"

Repair—Renewal—New Service W.C.#7167 DeFlice #1177

Location NOV 18 1968





| Date | Material | Amount | Total | Date | Amount |
|--------|-------------------------|--------|--------|------------------|----------------------|
| 8/9/68 | Outside Labor | 204 88 | | | 225 00 |
| | 10% O.H. | 20 49 | 225 37 | 11-14 12-3-68 | 96 50 |
| 25' | 6" transite pipe @ .88 | | 22 00 | | 391 50 |
| 1 | 90° elbow | | 4 09 | 8/12/68 | 178 96 |
| 2 | 1'x6" nipples @ .65 | | 1 30 | 8/14/68 | 24 56 |
| 1 | Saddle | | 5 50 | 8/15/68 | 12 28 |
| 1/4 | Bag cement @ 1.55 | | 39 | 9/4/68 | 15 71 |
| 15 | Sticks dynamite @ .27 | | 4 05 | 9/9/68 | 11 07 |
| 9 | Caps @ .33 | | 2 97 | | 242 58 |
| 1 1/2 | Tons hot top @ 5.80 | | 8 70 | 8-29-68 | 28' 6" Transite pipe |
| 1/2 | Yd. loam | | 88 | 10' | 4" Cast Iron |
| 1 | Lb. seed | | 1 10 | | |
| 1 | Hr. loader | | 4 80 | | |
| | Ton crushed rock | | 6 50 | | |
| 5 1/2 | Hrs. truck @ 3.00 | | 16 50 | | |
| 4 1/2 | " " @ 1.50 | | 6 40 | | |
| 1 1/2 | " shovel @ 6.50 | | 35 75 | | |
| 1 1/2 | " compressor @ 5.00 | | 22 50 | | |
| 1/2 | " roller & trailer | | 3 50 | | |
| | | | 371 50 | | |

Deposit Paid

NON-CHARGE

Inside

COMPLETED STAGE II

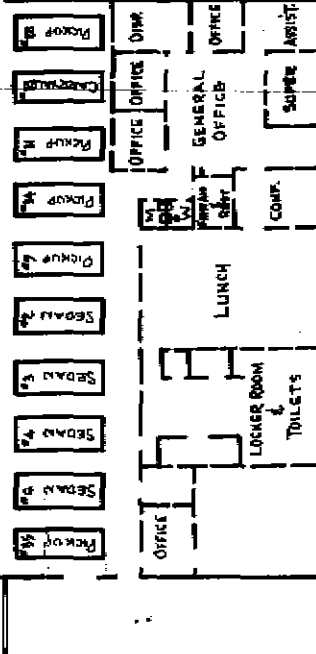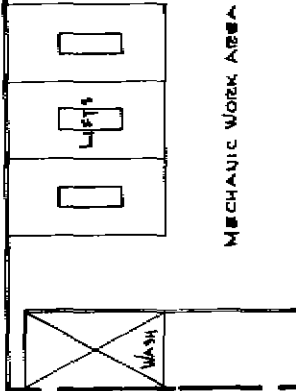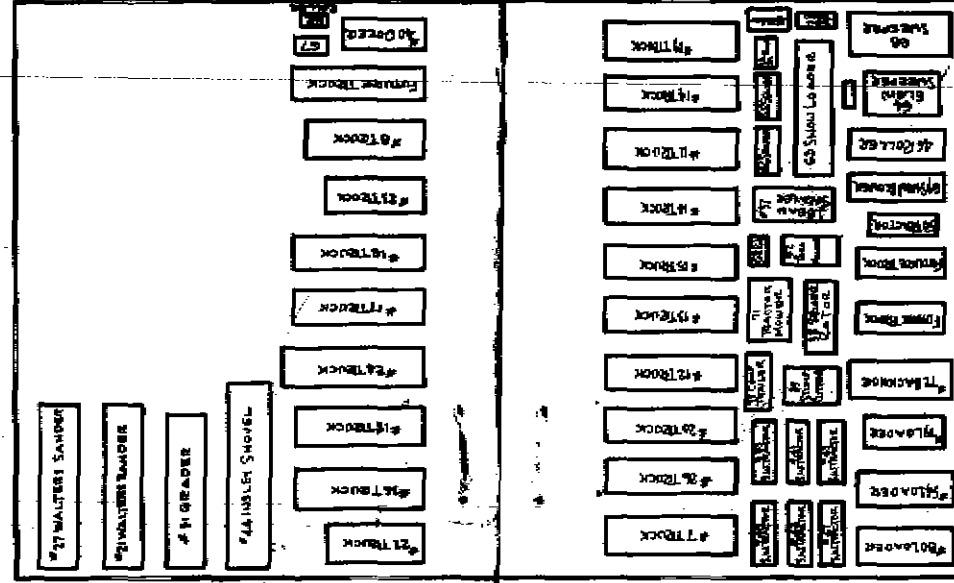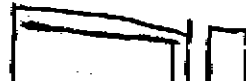

7+80
~~7+40~~

SMH.

253.5'

5+24.5

SMH.

42.5'

266.5'

2+60

SMH.

Barn

WYE 9' DEEP

Point in St.
for pipe direction


18 Middle St.

18 Middle St.

DATE _____

TOWN OF LEXINGTON . — BOARD OF PUBLIC WORKS

SEWER DIVISION

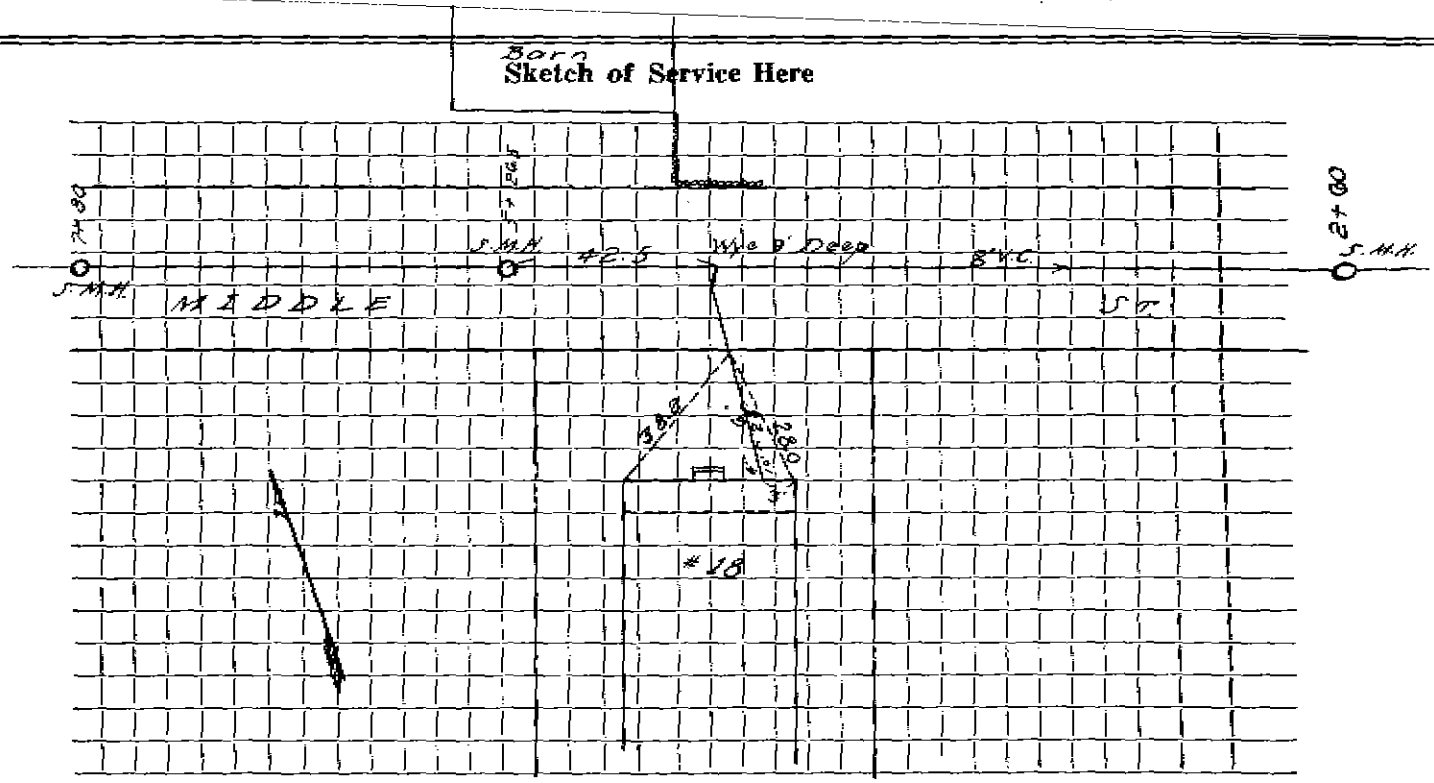

Connection made in Street. Work completed

Remarks:
.....
.....