

Name Roy M. Scott

Service No. 155

Address 22 Middle Street

22 Middle ST.

Location

Comm. 11-18-57

Kind of Pipe

Size

Size of Main

~~Repair—Renewal~~—New Service

Location

Date	Material	Amount	Total	Date	Amount
9/20/57	Labor	77 47		9-16-57	Deposit \$200 00
9/23/57	"	34 57		11-18-57	Refund 1 38
		112 04			\$198 62
	10% overhead	11 20	123 24		
	60' - 6" Transite @ .70		42 00		
	1 - 6" Clay Elbow		1 88		
	12x3 Patch		12 00		
	3 hrs. Town Shovel @ 6.50		19 50		
			198 62		
	<b>Labor</b>				

TOWN OF LEXINGTON—DEPT. OF PUBLIC WORKS  
SEWER DIVISION

DATE .....

NO. ....


The undersigned applies for the construction of a particular sewer connecting No. ....  
Street and hereby agrees to comply with the Rules and Regulations governing the construction and use of Particular  
Sewers, as now or at any future time established by the Board of Selectmen.

Am't of estimate \$.....

Am't Paid \$.....

..... Owner

Sketch of Service Here

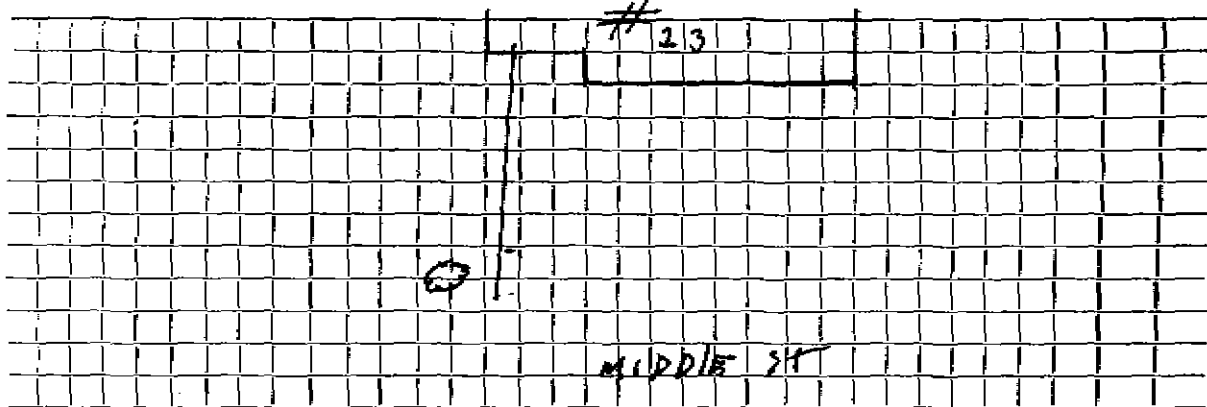

Connection made in ..... Street.

Work completed ..... 19..

Remarks:

Name Roy M. Scott

Service No. 155

Address 22 Middle Street

22 Middle ST.

Location

Comm. 11-18-57

Kind of Pipe

Size

Size of Main

~~Repair~~—Renewal—New Service

Location

Date	Material	Amount	Total	Date	Amount
9/20/57	Labor	77 47		9-16-57	Deposit \$ 200 00
9/23/57	"	34 57		11-18-57	Refund 1 38
		<u>112 04</u>			\$ 198 62
	10% overhead	11 20	123 24		
	60' - 6" Transite @ .70		42 00		
	1 - 6" Clay Elbow		1 88		
	12x3 Patch		12 00		
	3 hrs. Town Shovel @ 6.50		19 50		
			<u>198 62</u>		
	Labor				

**TOWN OF LEXINGTON—DEPT. OF PUBLIC WORKS**  
**SEWER DIVISION**

DATE.....

NO.....

The undersigned applies for the construction of a particular sewer connecting No.....  
Street and hereby agrees to comply with the Rules and Regulations governing the construction and use of Particular  
Sewers, as now or at any future time established by the Board of Selectmen.


Am't of estimate \$.....

Am't Paid \$.....

..... Owner

---

**Sketch of Service Here**

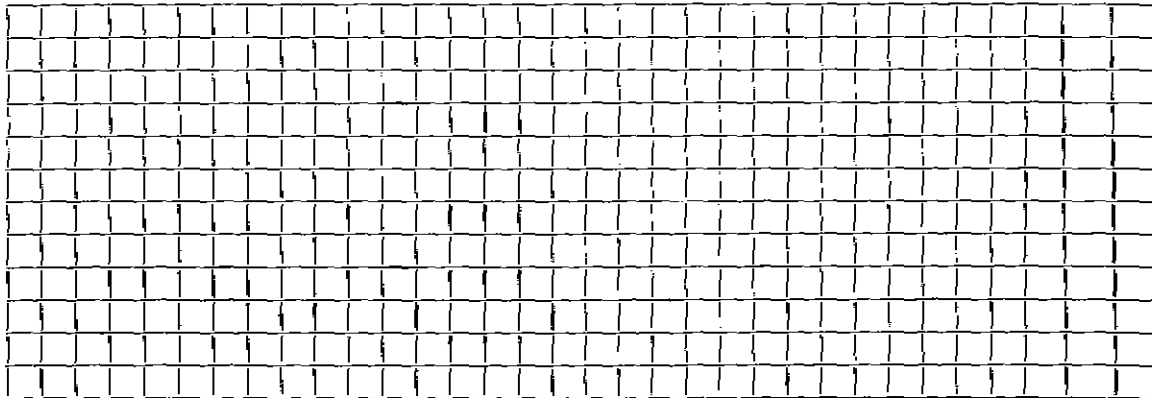

Connection made in..... Street.

Work completed.....19..

Remarks: