

Name Frank A. Napoli

Service No. 213

Address 23 Middle Street

23 Middle ST.

Location

Kind of Pipe

Size 6"

Size of Main 8"

~~REPAIR~~ ~~RENEW~~ ~~NEW~~ New Service

Comm. 12-19-55

Location

Date	Material	Amount	Total	Date	Amount
10/31/55	Labor	29 97		10-25-55	Deposited 1900 00
11/1/55	Labor	43 77		12-19-55	Refunded 70 03
	10% Overhead	7 37	81 11		229 97
	56' 6" Sewer pipe @ .32		17 92		
	Joint Compound		3 36		
	13 1/3 hrs. Ltfld. shovel @ .50	28.50	113 33		
	3 hrs. Trucking @ .75		2 25	11/17/99	
	12 x 3 Patching		12 00		ROOTS OUT - 49' AND 60' FROM C.O.
			229 97		OWNER PROBLEM
	Labor				

TOWN OF LEXINGTON—DEPT. OF PUBLIC WORKS
SEWER DIVISION

DATE

NO.


The undersigned applies for the construction of a particular sewer connecting No.
Street and hereby agrees to comply with the Rules and Regulations governing the construction and use of Particular
Sewers, as now or at any future time established by the Board of Selectmen.

Am't of estimate \$.....

Am't Paid \$.....

..... Owner

Sketch of Service Here

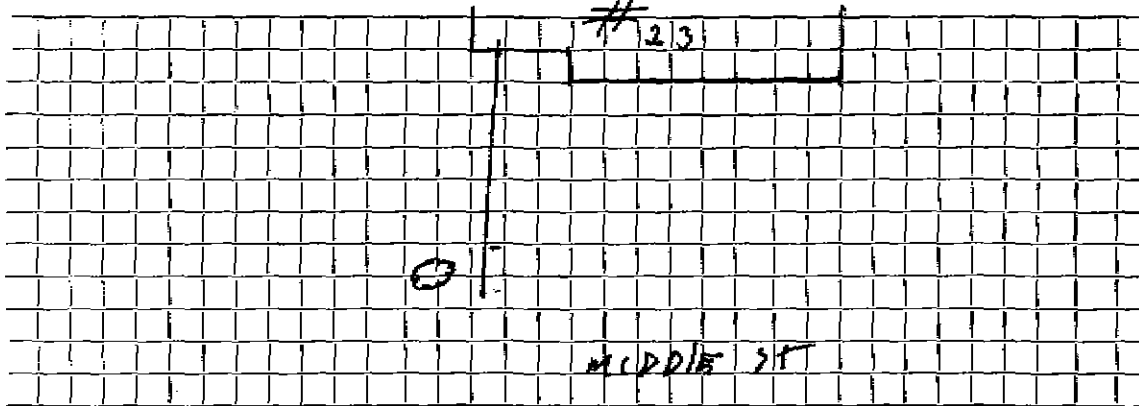

Connection made in Street.

Work completed 19..

Remarks: