

Name William H. Sullivan

Service No. 93

Address 36 Middle St.

Lexington

Location 36 Middle ST.

Kind of Pipe

Size 6"

Size of Main 8"

~~XXXXXXXXXX~~ New Service

COM. 7-13-53

Location

Date	Material	Amount	Total	Date	Amount
5/26/53	Labor	27 94		5-22-53	Deposited 125 00
5/28/53	Labor	<u>29 17</u>		7-13-53	Paid 1 67
		57 11		7-22-53	" (12 03)
	10% overhead	5 71	62 82		138 70
	50' - 5" Transite Pipe @.55		27 50		
	1-6" Elbow		1 88		
	4 Hr. Littlefield Shovel @7.50		30 00		
	2 Hr. Trucking @.75		1 50		
	Patching 15 x 3		<u>15 00</u>		bill sent 7-13-53
			138 70		
	Labor				

**TOWN OF LEXINGTON—DEPT. OF PUBLIC WORKS
SEWER DIVISION**

DATE.....

NO.


The undersigned applies for the construction of a particular sewer connecting No.....
Street and hereby agrees to comply with the Rules and Regulations governing the construction and use of Particular
Sewers, as now or at any future time established by the Board of Selectmen.

Am't of estimate \$.....

Am't Paid \$.....

..... Owner

Sketch of Service Here

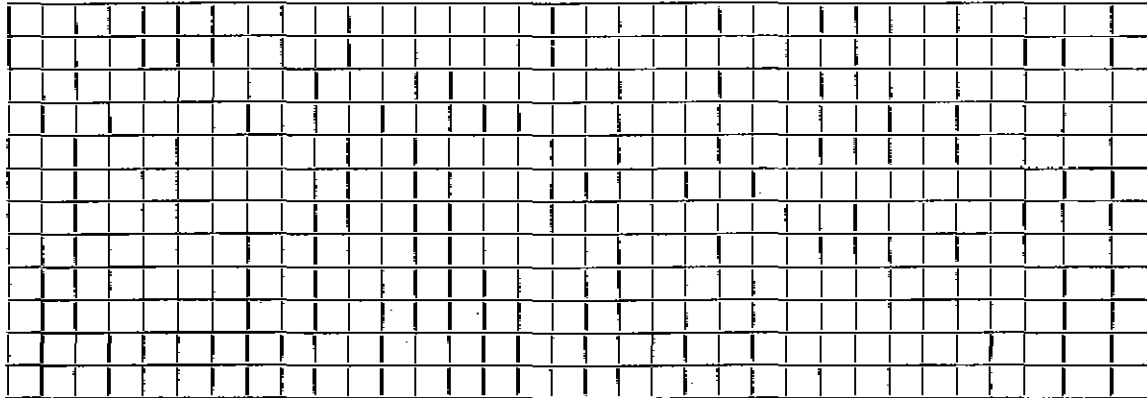

Connection made in..... Street. Work completed..... 19..

Remarks: