

Name Jo Jen Realty

Service No. 147

Address 41 Middle Street

41 Middle ST.

Location

Kind of Pipe

Size 6"

Size of Main 8"

~~Repair/Reconnect~~ New Service

W.O. #7192

Location APR 6 1970

Date	Material	Amount	Total	Date	Amount
12/9/69	Labor		63 68	12-3-69	Deposit 235 00
	10% O.H.		6 37	4-6-70	Refund 103 71
25'	6" Transite pipe .88		22 00	12-9-69	121 39
1/4	Bag cement @ 1.55		39	25'	6" TRANSITE
1	Ton cold patch		5 85		
2	Hrs. trucking 3.00		6 00		
1	Hr. loader		4 00		
2	Hrs. shovel 6.50		13 00		
			121 29		
1/20/70	27' Transite (6") - - Dave Eagle permit #1703				
	10' Cast Iron(4")				


DATE _____

TOWN OF LEXINGTON — BOARD OF PUBLIC WORKS

SEWER DIVISION

Sketch of Service Here

41

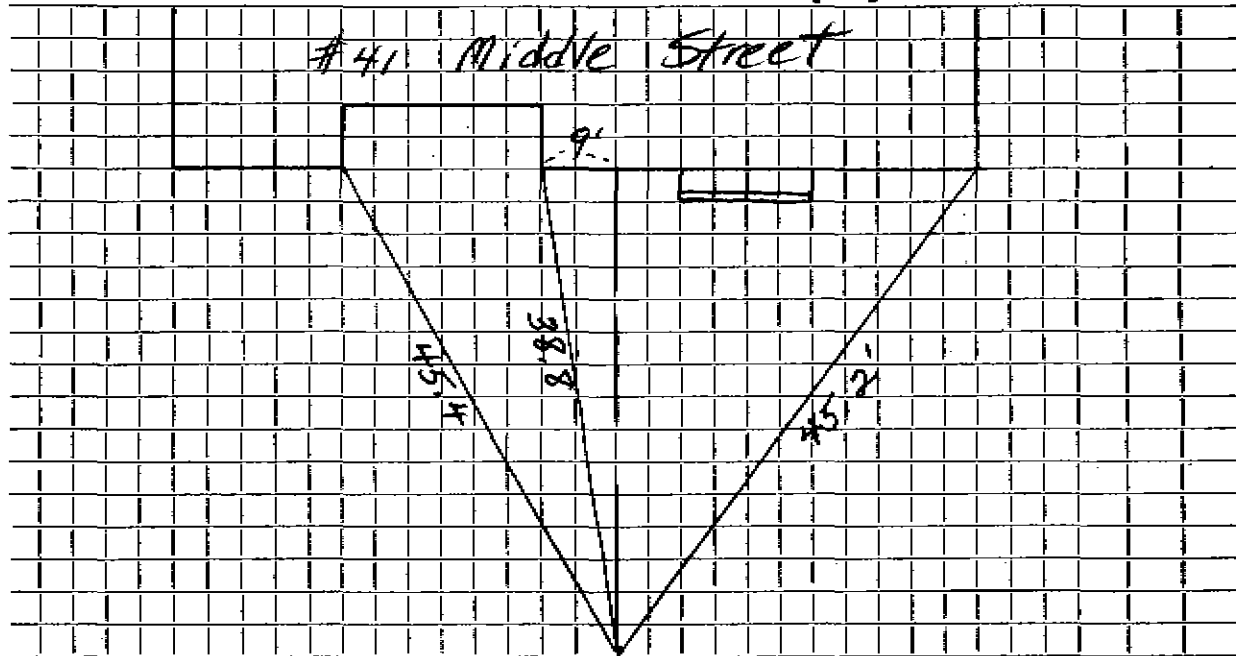

Connection made in Street. Work completed

Remarks:

.....

.....