

Name **Jennie E. Perkins**

Service No. **132**

Address **42 Middle Street**

**42 Middle ST.**

Location

Kind of Pipe

Size **6"**

Size of Main **8"**

~~XXXXXXXXXX~~ - New Service

COM. 11-8-54

Location

Date	Material	Amount	Total	Date	Amount
10/6/54	Labor	57 83		8-30-54	200 00
	10% overhead	5 78	63 39	11-8-54	(36 89)
	94' - 6" sewer pipe @ .32		30 08		163 11
	joint compound		5 64		
	7 hrs. Littlefield shovel @ .75	5 25	52 50		
	2 hrs. trucking @ .75	1 50			
	patching 10 x 3		10 00		
			<u>163 11</u>		
	Labor			1-7-66	S.B.
				10-21-75	Solids

# TOWN OF LEXINGTON—DEPT. OF PUBLIC WORKS

## SEWER DIVISION

DATE .....

NO. ....


The undersigned applies for the construction of a particular sewer connecting No. ....  
Street and hereby agrees to comply with the Rules and Regulations governing the construction and use of Particular  
Sewers, as now or at any future time established by the Board of Selectmen.

Am't of estimate \$.....

Am't Paid \$.....

..... Owner

### Sketch of Service Here

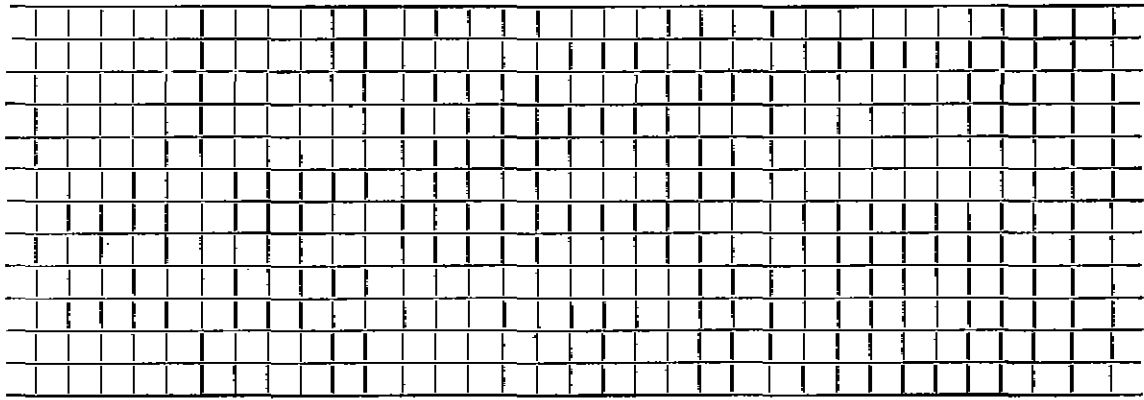

Connection made in ..... Street.

Work completed ..... 19..

Remarks: