

Name R.D. Hamilton Construction Co., Inc.

Service No. 116

Address 44 Middle Street

44 Middle ST.

Location

Kind of Pipe

Size 6"

Size of Main 8"

~~Repair - Renewal~~ New Service

W. O. # 9993

Location

FEB 12 1973

Date	Material	Amount	Total	Date	Amount
9/7/72	Labor	92 40		8/15/72	Deposit 275 00
9/19/72	"	46 01		2/12/73	Refund 56 06
	10% O.H.	13 84	152 25		218 94
	20' Transite pipe .90		18 00		
	½ Bag cement @ 1.98		99		
	10 Brick .07		70		
	2 Ton Cold patch 8.00		16 00		
	3 Hrs. Trucking 3.00		9 00		
	2 Hrs. Shovel 6.50		13 00		
	1 Hr. Compressor		5 00		
	1 Hr. Roller		2 00		
	Trailer		2 00		
Repair 7/1/94	6'-6" PUC		218.94		
	2 AC TO PUC Ferraco				


TOWN OF LEXINGTON — BOARD OF PUBLIC WORKS

SEWER DIVISION

DATE \_\_\_\_\_

Sketch of Service Here

99

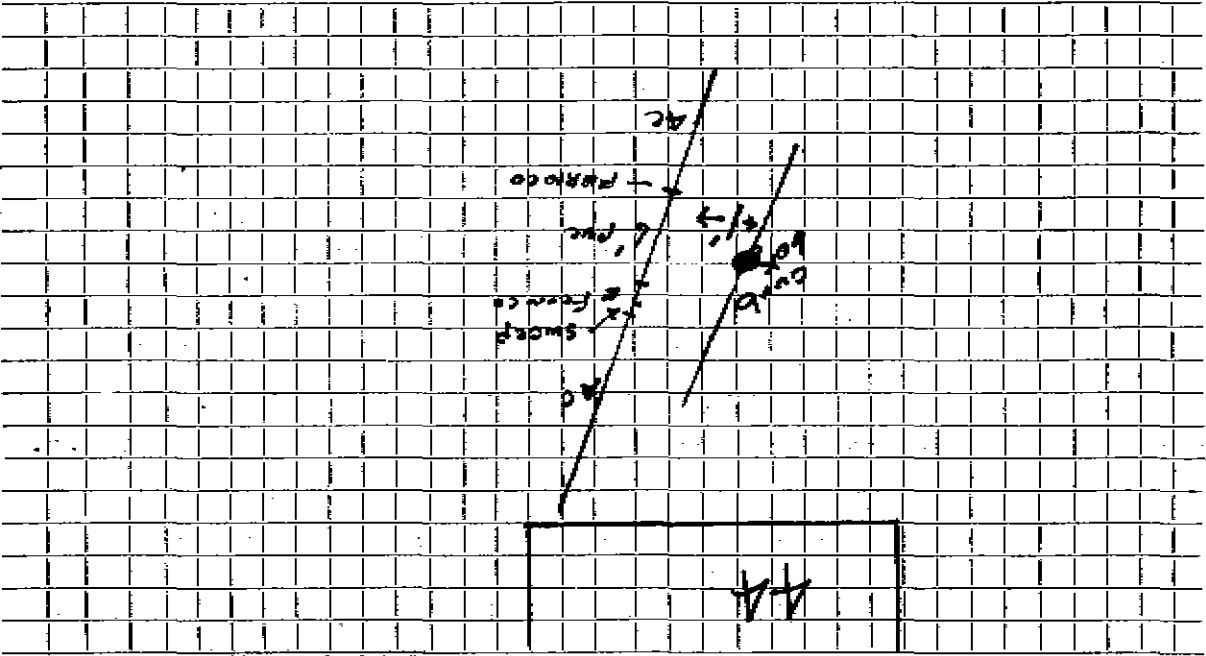

Connection made in Street. Work completed

Remarks: