

Name Lawrence Moulthrop

Service No. 138

Address 45 Middle St.

Lexington

Location 45 Middle ST.

Kind of Pipe

COM. 9-14-53

Size 6"

Size of Main 8"

~~Subcontract~~ New Service

Location

Date	Material	Amount	Total	Date	Amount
L/53	Labor	47 69		7-22-53	Deposited 700 00
	10% overhead	4 77	52 46	9-14-53	Refund 55 64
	78' - 5" Transite Pipe @.55		42 90		144 36
	5 Hr. Littlefield Shovel @7.50		37 50		
	2 Hr. Trucking @.75		1 50		
	Patching 10 x 3		10 00		
			144 36		
				12/8	Respond + measure for
				1-27-89	64' x 78' Possible paper
				3-12-92	S.B. 68' out
	Labor				Repair MADE 3-24-92
					13' 6" PVC
					2- 6" x 6" PVC to PVC Feeder

TOWN OF LEXINGTON—DEPT. OF PUBLIC WORKS
SEWER DIVISION

DATE

NO.


The undersigned applies for the construction of a particular sewer connecting No.
 Street and hereby agrees to comply with the Rules and Regulations governing the construction and use of Particular
 Sewers, as now or at any future time established by the Board of Selectmen.

Am't of estimate \$.....

Am't Paid \$.....

..... Owner

Sketch of Service Here **45**

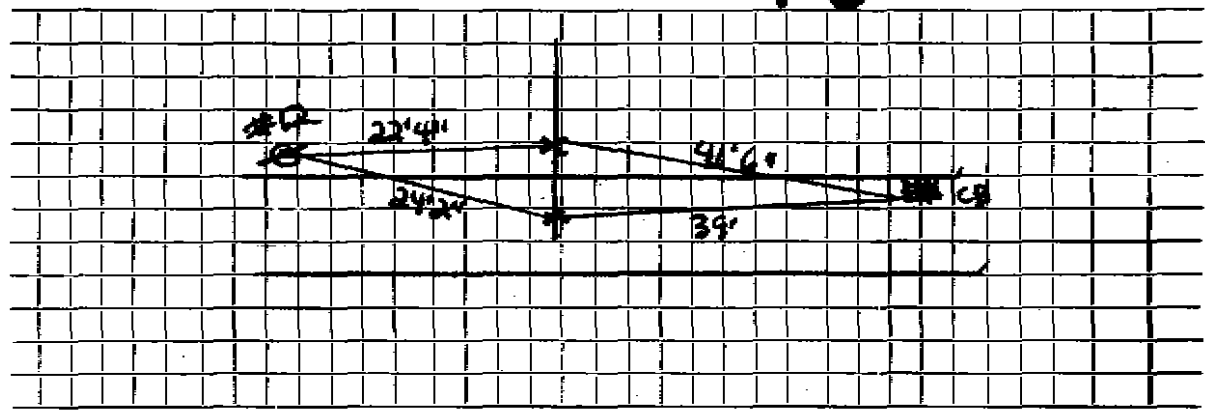

Connection made in Street.

Work completed 19..

Remarks: