

Name **Joseph Chisholm**Service No. **141**Address **52 Middle Street****52 Middle ST.**

Location

Kind of Pipe

Size **6"**Size of Main **8"**~~REWORK~~ **New Service****COM. 11-8-54**

Location

Date	Material	Amount	Total	Date	Amount
10/7/54	Labor	53 93		10-1-54	Deposited 250 00
10/8/54	"	37 68	91 61	11-8-54	Refunded 110 47
	10% overhead		9 16		239 53
	102' - 6" sewer pipe @ .32		32 64		
	joint compound		6 12		
	10 hr. Littlefield shovel @ 7.50		75 00		
	4 hrs. trucking @ .75		3 00		
	patching 22 x 3		22 00		
			<u>239 53</u>		
	Labor				

TOWN OF LEXINGTON—DEPT. OF PUBLIC WORKS

SEWER DIVISION

DATE

NO.


The undersigned applies for the construction of a particular sewer connecting No.
Street and hereby agrees to comply with the Rules and Regulations governing the construction and use of Particular
Sewers, as now or at any future time established by the Board of Selectmen.

Am't of estimate \$.....

Am't Paid \$.....

..... Owner

Sketch of Service Here

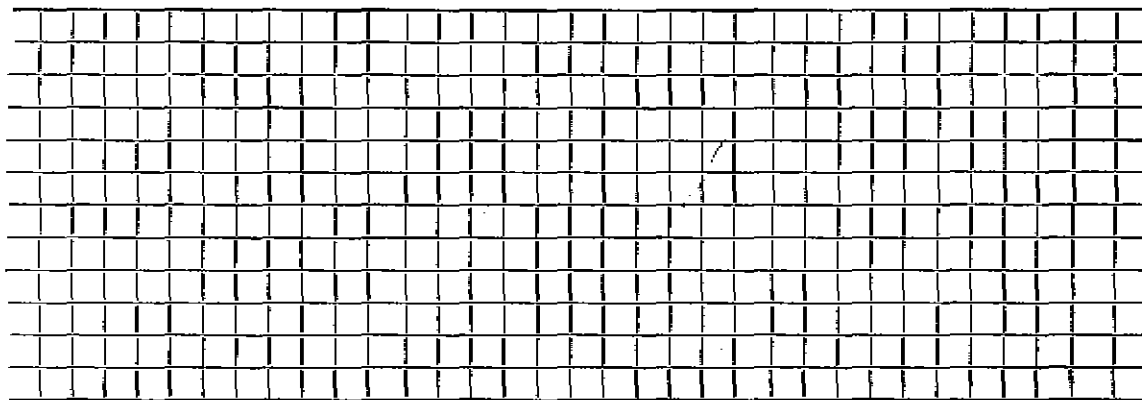

Connection made in Street.

Work completed 19..

Remarks: