

Name **ALFRED FARINOLI**

Service No. **118**

Address **54 Middle Street**

**54 Middle ST.**

Location

Kind of Pipe

Size **6"**

Size of Main **8"**

~~REVISIONS~~ **New Service W.O. #8194**

Location **Comm 2-10-64**

Date	Material	Amount	Total	Date	Amount
1/3/63	Labor	80 26		9-12-63	Deposit 250 00
	10% O.H.	8 03	88 29	2-10-64	Retrad 39 38
	37' 6" Transite Pipe @ .82		30 34		210 72
	1 90° Transite Elbow		4 09		
	4 Hrs. Town Shovel @ 6.50		26 00		
	2 Hrs. Trucking @ 3.00		6 00		
	56 X 3 Patch		56 00		
			<u>210 72</u>		


DATE \_\_\_\_\_

TOWN OF LEXINGTON — BOARD OF PUBLIC WORKS

SEWER DIVISION

Sketch of Service Here

54

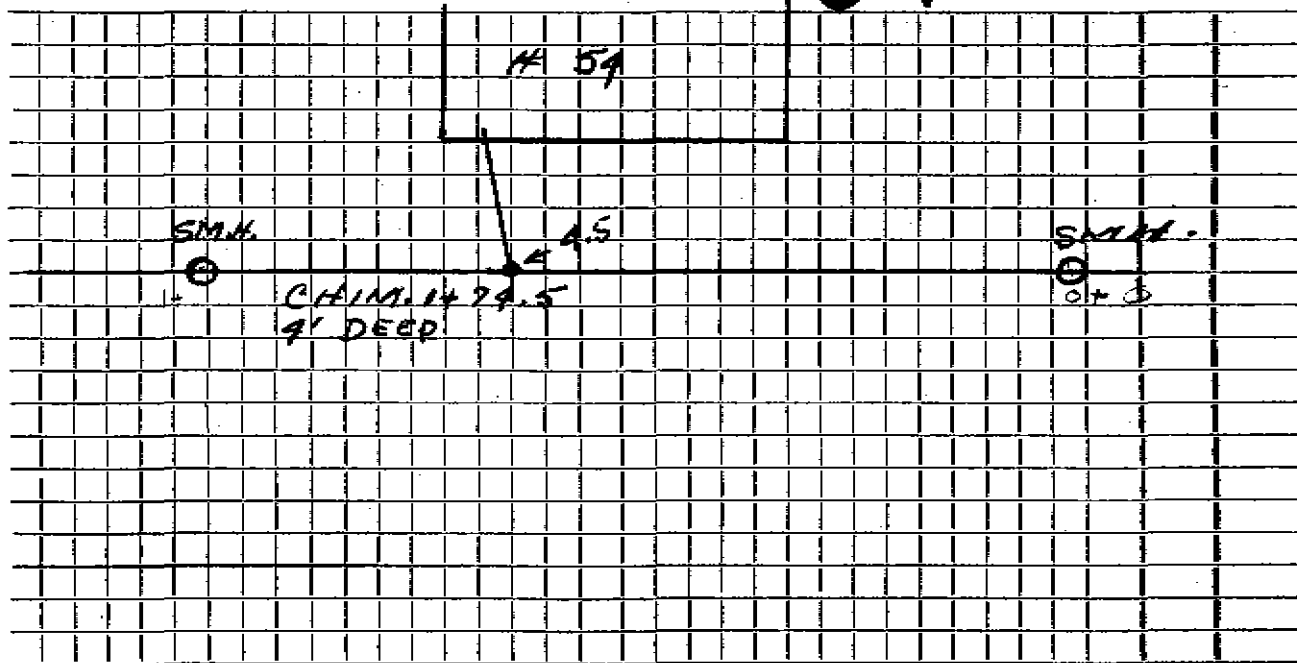

Connection made in ..... Street. Work completed .....

Remarks: .....  
.....  
.....