

Name

Service No.

Address 58 MIDDLE ST
58 Middle St.

Location

Kind of Pipe PVC

Size 6"

Size of Main 8"

Repair—Removal (New Service)


Location

Date	Material	Amount	Total	Date	Amount
1/26 89				<u>Note</u>	
	88' 6" PVC			old	service not used
	2 1/2" BEND				
	Ø X 6 SINKER SABLE				
	6" wye & cap				

TOWN OF LEXINGTON — BOARD OF PUBLIC WORKS

SEWER DIVISION

Sketch of Service Here

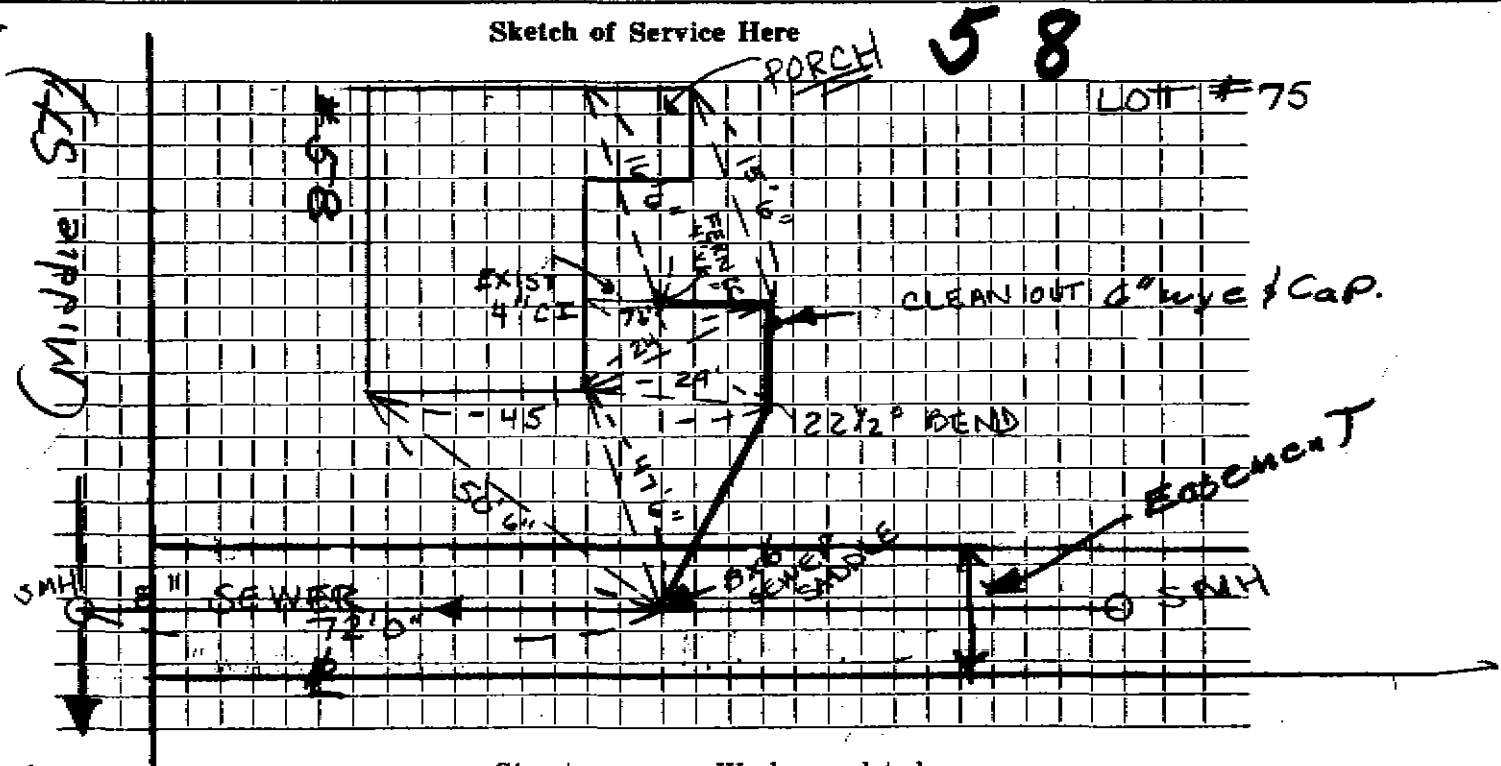

Connection made in Street. Work completed

Remarks:

.....

.....