




DATE 20 JUNE 1995

TOWN OF LEXINGTON — BOARD OF PUBLIC WORKS  
SEWER DIVISION

Sketch of Service Here **60**

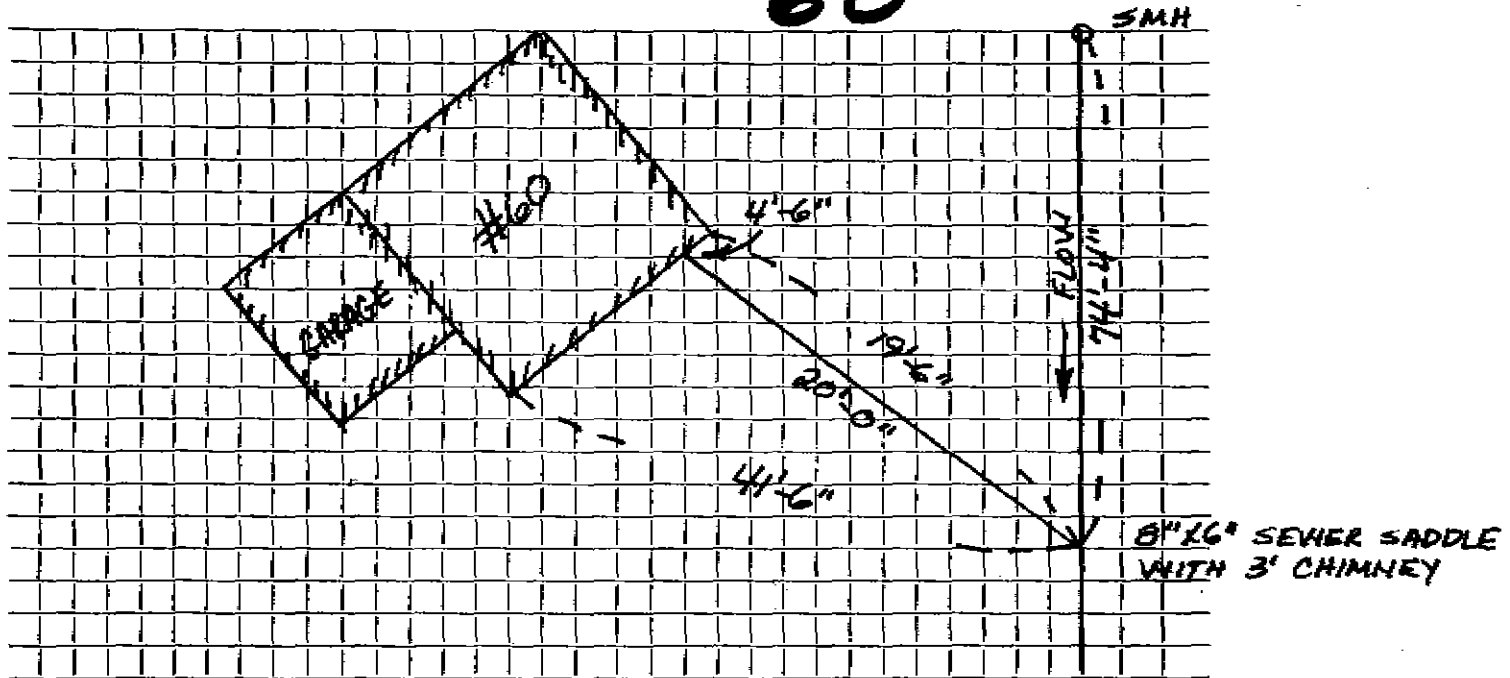

Connection made in MIDDLE STREET Street.

Work completed J.M. MCLAUGHLIN, INC

Remarks: .....

BOOK 96A

J.W.