

Name **Edwin Reed Standa**

Service No. **79**

Address

222 Middle Street E ST

22 Middle St.

Location

Kind of Pipe

Size **6"**

Size of Main **8"**

Repair—~~Remove~~ **New Service**

WO # 8052

Location **Comm 10-28-63**

Date	Material	Amount	Total	Date	Amount
-63	LABOR	123 56		6-28-63	Deposit
-63		10 84		10-21-63	Refund
	10% O.H.	13 44	147 84		
	50' 6" Transit Pipe @ .82		41 00		
	1 6" x 12" Nipple		1 21		
	1 900 Transit Elbow		4 09		
	1 Service Saddle		5 25		
	1 5 x 3 Patch		15 00		
	8 Yds. Loom @ 3.00		24 00		
			238 39		


DATE _____

TOWN OF LEXINGTON — BOARD OF PUBLIC WORKS

SEWER DIVISION

Sketch of Service Here

62

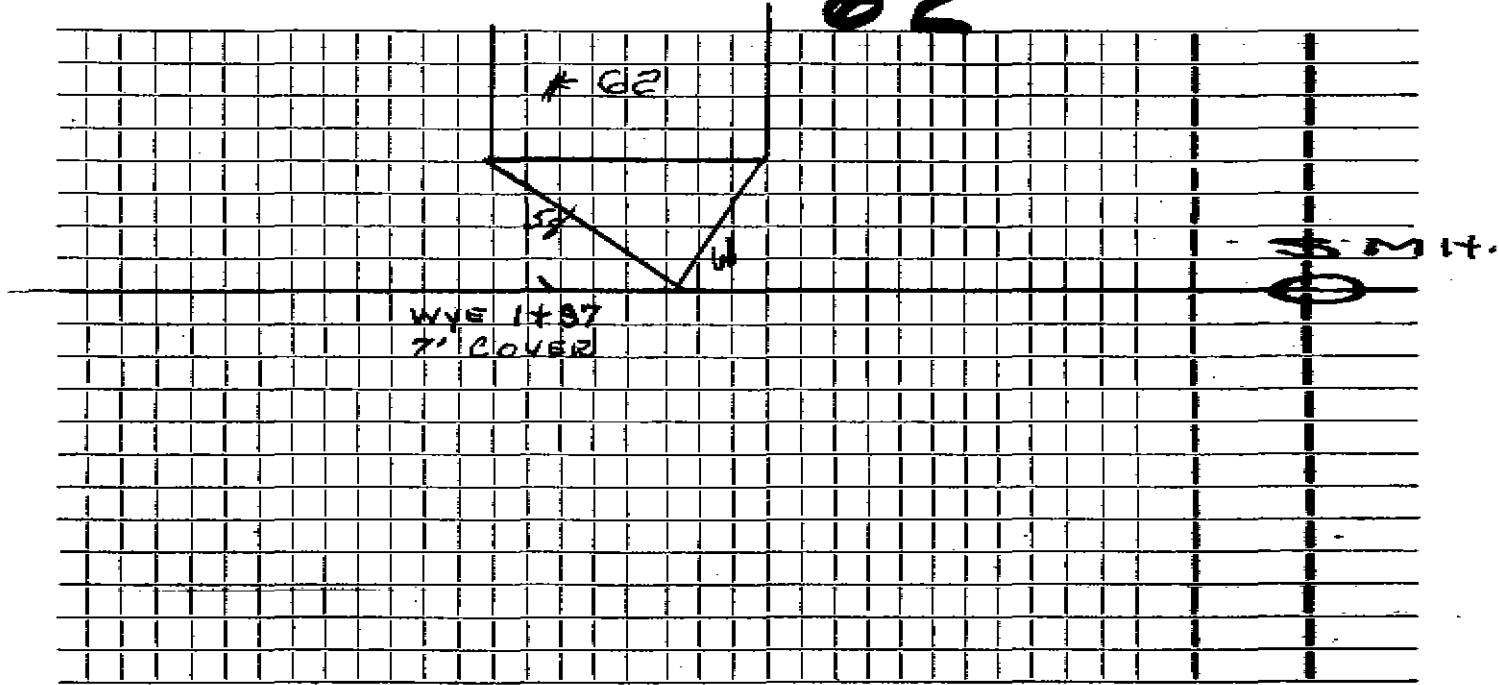

Connection made in Street. Work completed

Remarks:
.....
.....