

Name **Donna Realty Trust**

Service No.

Address **64 Middle Street**Lot **176**Location **64 Middle ST.**

Kind of Pipe

Size **6"**Size of Main **8"**~~REPLACEMENT~~ **New Service W.O. #4622 Valeri #575**Location **JAN 22 1968**


Date	Material	Amount	Total	Date	Amount
7-67	33' 6" Transite pipe			5-16-67	Deposit 150 00
	10' 4" Cast Iron Pipe				
				5-8-67	
1/16/67	Labor	116.84			20' 6" Transite
1/8/67	"	21.24			1 6" Nipple
1/8/67	"	12.54	150 62		1 6"-90° Elbow
	10% O.H.	15 06	165 68		1 6"x8" Saddle
	20' 6" Transite Pipe @	88	17 60	12-27-75	Solids
	1 8 x 6 Saddle		5 50		
	1 6" Nipple		91		Bill sent 95.78
	1 90° Elbow		4 09		
	1/2 Load Stone		4 40	2	Hrs. Shovel @ 6.50 13 00
	2 Ton hot top @ 5.80		11 60	1	Hr. Compressor @ 5.00 5 00
	5 Hrs. trucking @ 3.00		15 00	1	Hr. Roller 3 00
					245 78

DATE _____

TOWN OF LEXINGTON — BOARD OF PUBLIC WORKS

SEWER DIVISION

Sketch of Service Here **64**

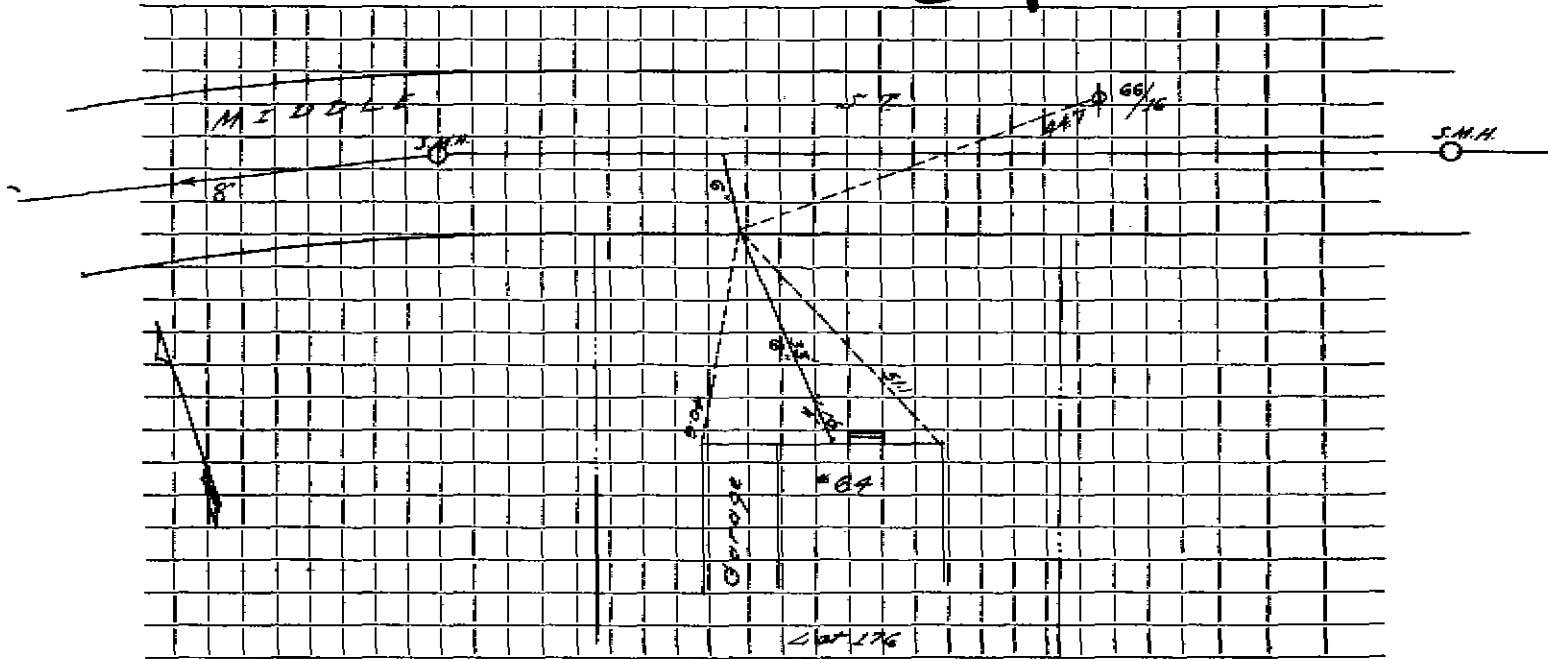

Connection made in Street. Work completed

Remarks:
.....
.....