

Name

Harbor Bush

Service No. 99

Address

70 Middle Street

70 Middle St.

Location

Kind of Pipe

Size 6"

Size of Main 8"

Material

WO# 8154

Location

Co. No. 10-28-63

Date

Material

Amount

Total

Date

Amount

20-63

LABOR

94.50

8-17-67

400.00

10% O.H.

9.49

104.99

8-28-63

148.87

137' 6" Transite pipe @.82

112.34

64 ton Stone @1.50

9.38

271.11

1 6" 90° Transite Elbow

4.09

1 6" Duplex Adapter

1.62

2 22 1/2" Transite Elbows @2.35

4.70

1 22 1/2" Transite Bend

4.09

3 hrs. Town Shovel @6.50

19.50

2 hrs. Trucking @3.00

6.00

1 hr. Loader @5.00

5.00

271.11


DATE _____

TOWN OF LEXINGTON — BOARD OF PUBLIC WORKS

SEWER DIVISION

Sketch of Service Here

70

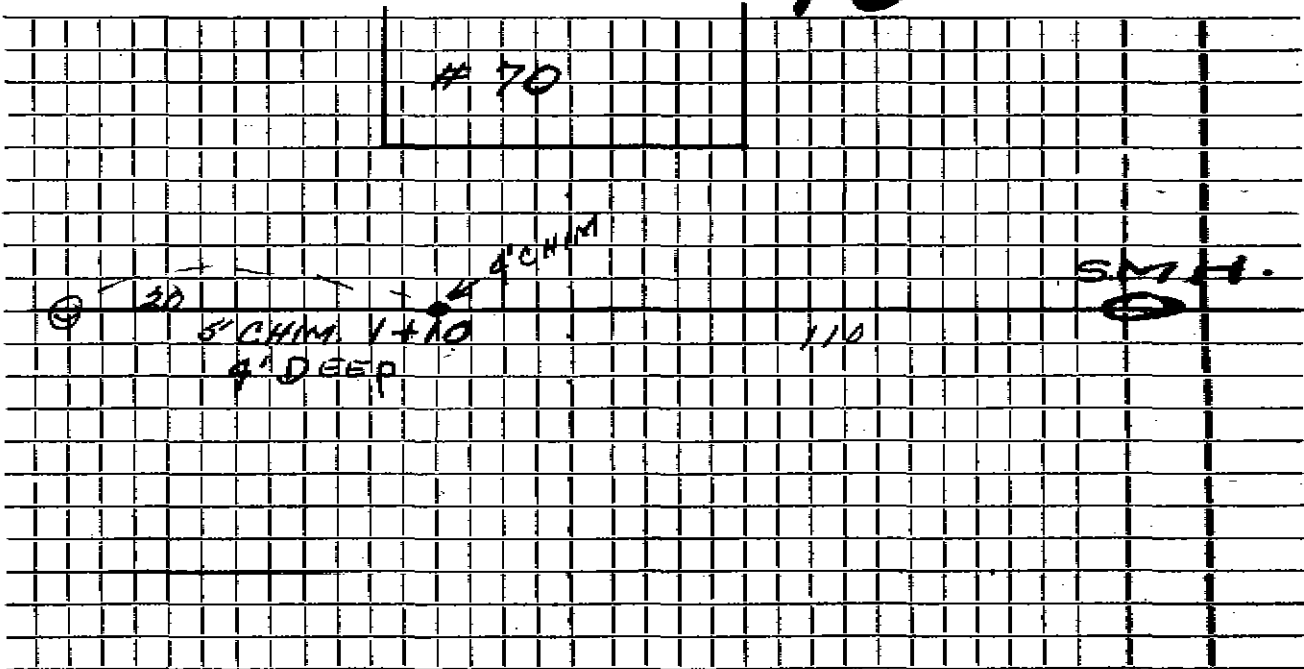

Connection made in Street. Work completed

Remarks: