

Name

Homes Realty

Service No.

Address 71 MIDDLE ST.

71 Middle St.

Location

Kind of Pipe PVC

Size 4" x 6"

Size of Main 8"

Repair—Renewal—New Service—McLaughlin #0180


Location

Date	Material	Amount	Total	Date	Amount
4-7-92	103 LF 6" PVC				
	5 LF 4" PVC				
	8 x 6" CI SADDLE				
	6" - 22° ELBOW				
	4" x 6" FERRO				

DATE \_\_\_\_\_

TOWN OF LEXINGTON — BOARD OF PUBLIC WORKS  
SEWER DIVISION

Sketch of Service Here **71**

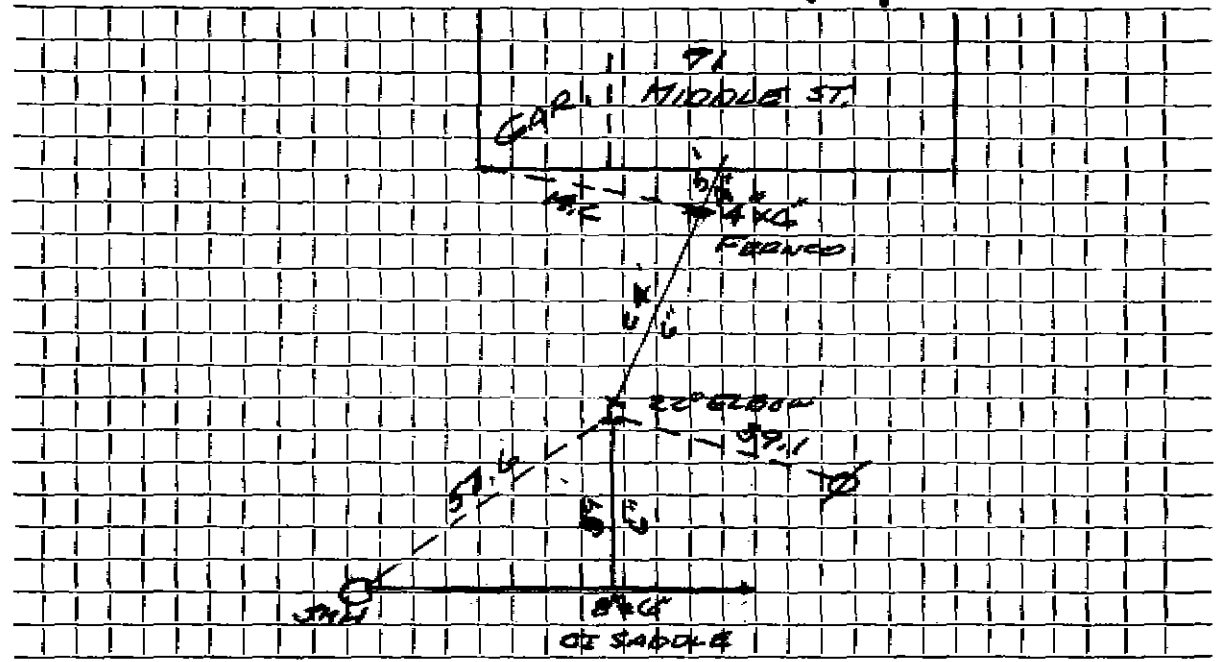

Connection made in MIDDLE ST. Street. Work completed .....

Remarks: .....  
CONTRACTOR J. McLAUGHLIN DID OUTSIDE & INSIDE WORK  
.....