

Thomas A. Napoli

Service No. 40

Address 735 Middle Street

23 Middle St.

Location

Kind of Pipe

Size 6"

Size of Main 8"

~~XXXXXXXXXXXX~~ - New Service

Location

Com. 6-19-61

Date	Material	Amount	Total	Date	Amount
11-61	Labor 69.97			4-28-61	
12-61	" 86.75	156.72		2-12-61	
	10% O.H.	15.67	172.39		
106'	6" Transite pipe @.78		82.68		
17 ton	3/4" Stone @1.50		25.50		
1	11 1/2" Transite Elbow		2.24		
1	90° Transite Elbow		5.40		
5	hrs. - Town Shovel @6.50		32.50		
5	hrs. - Trucking @3.00		15.00		
1	hr. - Trojan Loader @3.00		3.00		
2	hrs. - Pumping @1.00		2.00		
1	hr. - Traller @3.00		3.00		
15 x 3	Patch		15.00		
			358.71		

Deposit Paid


DATE _____

TOWN OF LEXINGTON — BOARD OF PUBLIC WORKS

SEWER DIVISION

Sketch of Service Here

73

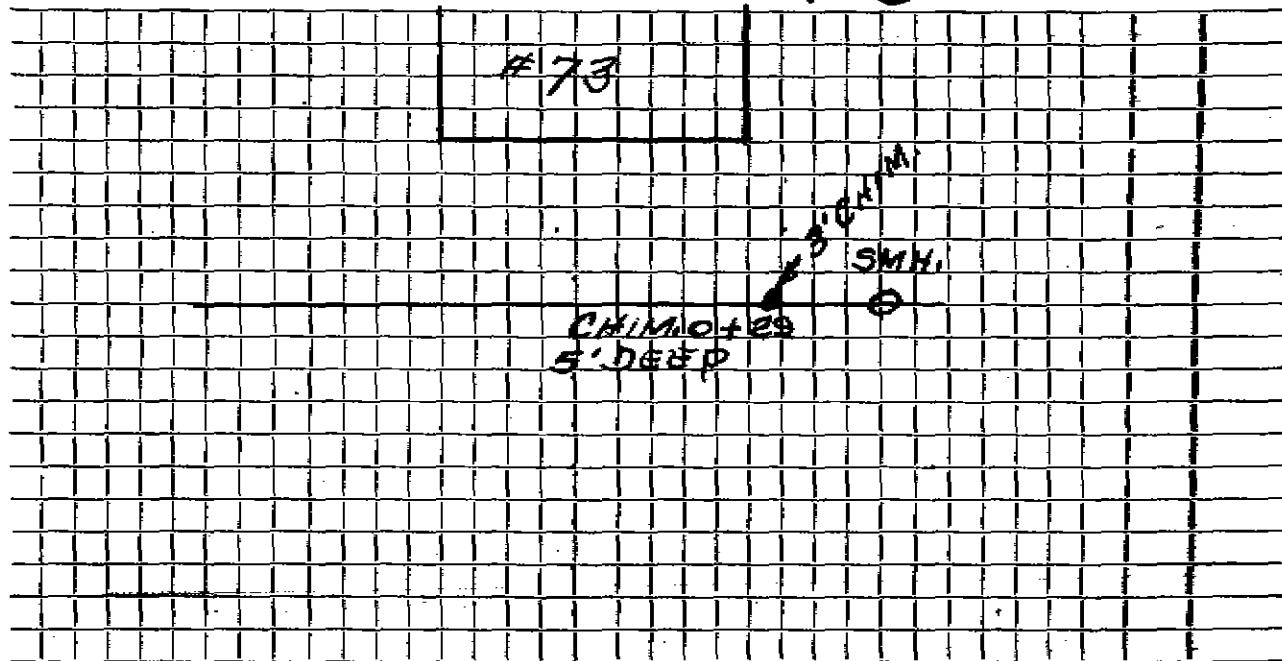

Connection made in Street. Work completed

Remarks:

.....

.....