

8. ~~Exterior~~ New Service

Service No. 241

Address 74 Middle Street

74 Middle St.

Location

Kind of Pipe

Size of Main 8"

Number of Joints - 3 New Service

Location Coated and Red

Date	Material	Amount	Total	Date	Amount
9-60	Labor	52.77	52.77	Aug 27	125.00
	10% O.H.	5.28	58.05	12-61	61.21
45:	6" Transite Pipe @ .78	35.10	35.10		187.31
1	6" Transite Adapter	1.90			
1	90° Transite Elbow	5.40			
4	ton #2 Stone @ 1.75	61.26	61.26		
3	hrs - Town Shovel @ 6.50	19.50	19.50		
2	hrs - Trucking @ 3.00	6.00	6.00		
					187.21


DATE _____

TOWN OF LEXINGTON — BOARD OF PUBLIC WORKS

SEWER DIVISION

Sketch of Service Here

74

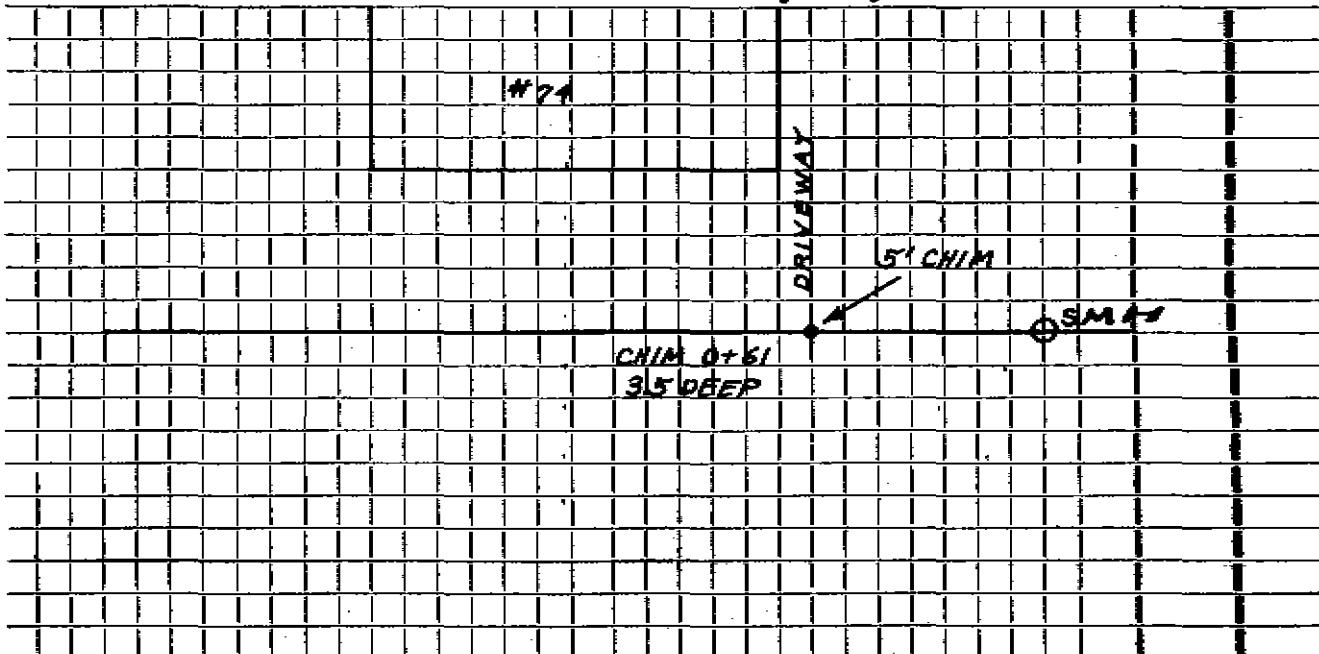

Connection made in Street. Work completed

Remarks: