


DATE 6/15/90

TOWN OF LEXINGTON — BOARD OF PUBLIC WORKS
SEWER DIVISION

Sketch of Service Here

80

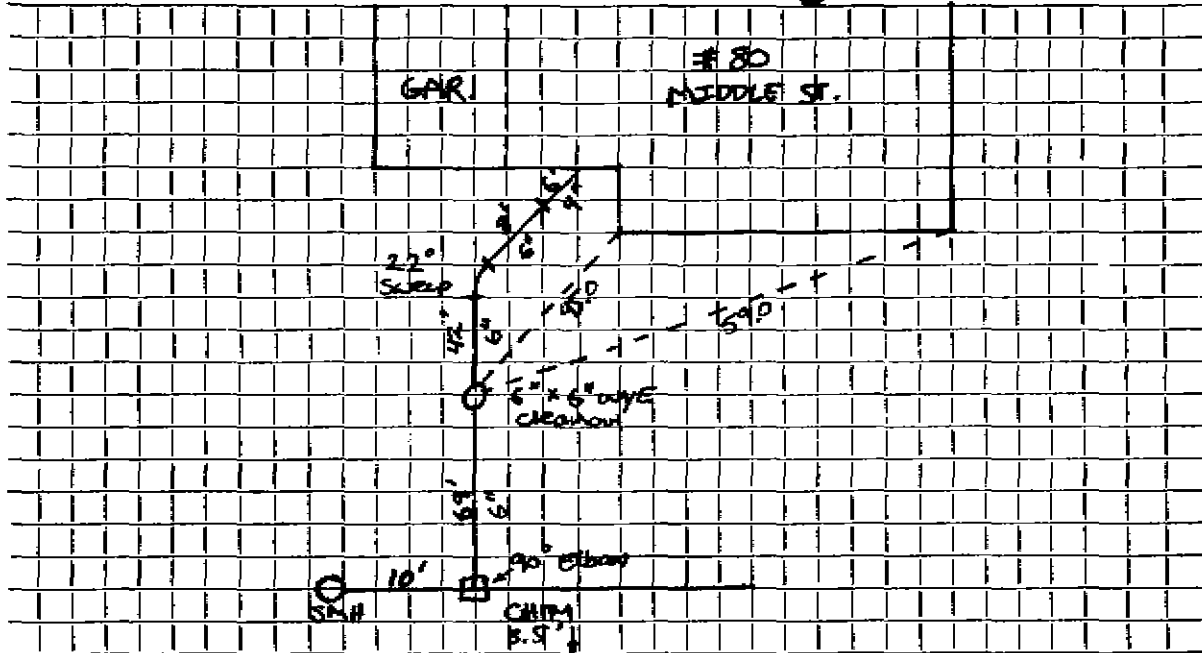

Connection made in Street. Work completed

Remarks: INSTALLED BY VALERE
INSPECTED BY CPS