

Name

Service No.

Address 82 MIDDLE ST

Location

Kind of Pipe

Size

Size of Main

Repair—Renewal—New Service

Location

Date	Material	Amount	Total	Date		Amount
------	----------	--------	-------	------	--	--------


7/99	15	4" PVC SCH 40					
	1	4x6 FERNCO					
	1	22"					
	1	WYE C.O.					
		6" PVC					

DATE _____

TOWN OF LEXINGTON — BOARD OF PUBLIC WORKS

SEWER DIVISION

Sketch of Service Here

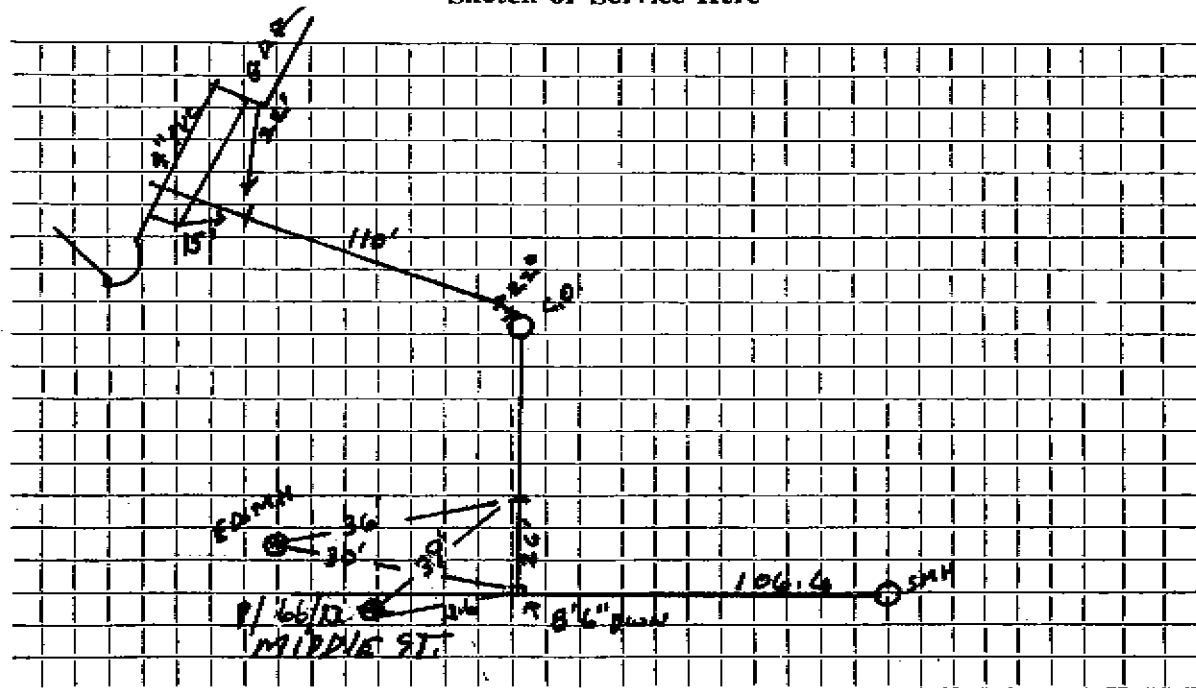

Connection made in MIDDLE ST. Street. Work completed


Remarks: Ties by Wally ST. C.T.

DATE _____

TOWN OF LEXINGTON — BOARD OF PUBLIC WORKS

SEWER DIVISION

Sketch of Service Here

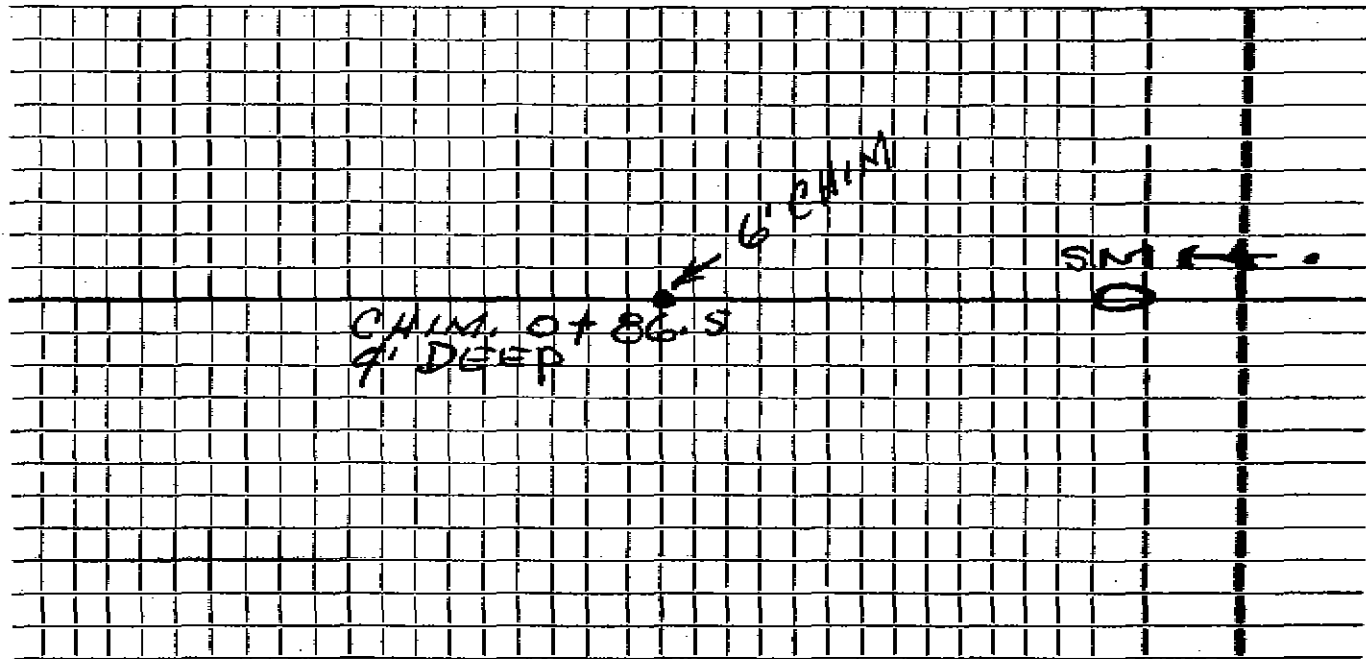

Connection made in Street. Work completed

Remarks:
.....
.....