


TOWN OF LEXINGTON — BOARD OF PUBLIC WORKS

SEWER DIVISION

Sketch of Service Here

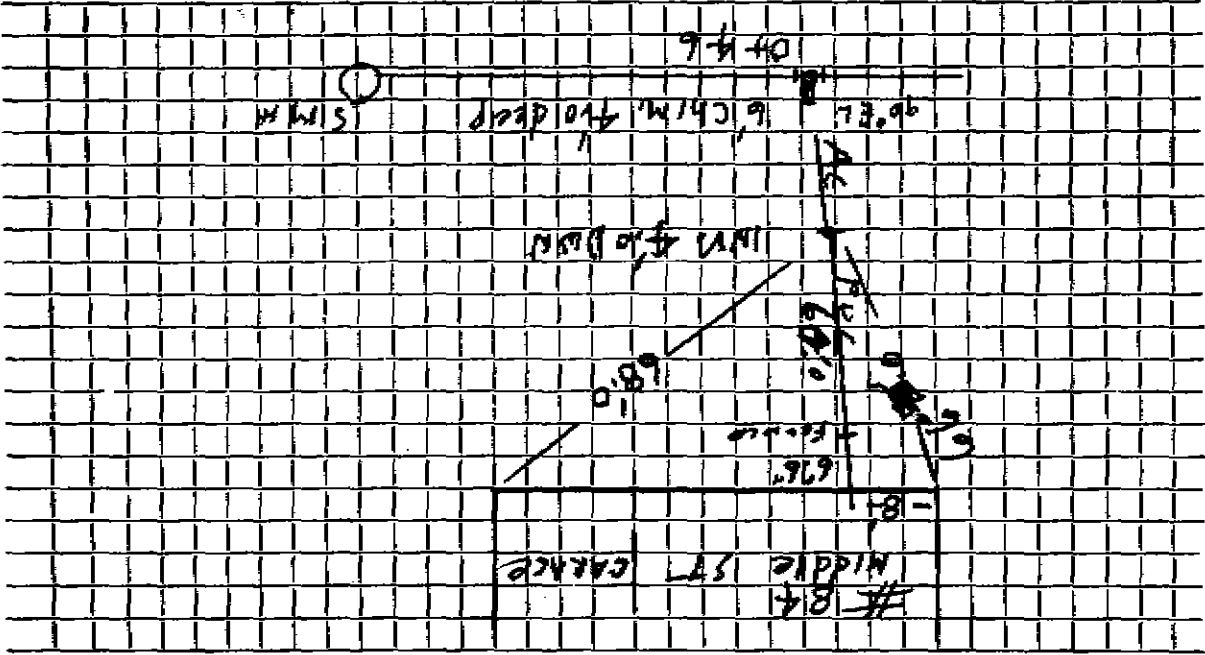

Connection made in
Remarks:

Street

Work completed 11/8/05

J. McLaughlin

DATE