

Name **E. J. Barrett**

Service No. **271**

Address **92 Middle Street**

**92 Middle ST.**

Location

Kind of Pipe

Size **6"**

Size of Main **8"**

~~XXXXXXXXXXXX~~ **New Service**

Location **C. m. 3-6-61**


Date	Material	Amount	Total	Date	Amount
2-7-60	Labor	43.63		11-30-60	136.00
	10% O.H.	4.36	47.99	3-6-61	23.91
50	6" Transitite Pipe @.78		39.00		126.09
1	6" T.I.P. Transitite Bend		5.10		
1	hrs. Ploppin Shovel @1.50		18.00		
2	hrs. Trucking @3.00		6.00		
10 x 3	Patch		10.00		
			<u>126.09</u>		

DATE \_\_\_\_\_

TOWN OF LEXINGTON — BOARD OF PUBLIC WORKS

SEWER DIVISION

Sketch of Service Here **92**

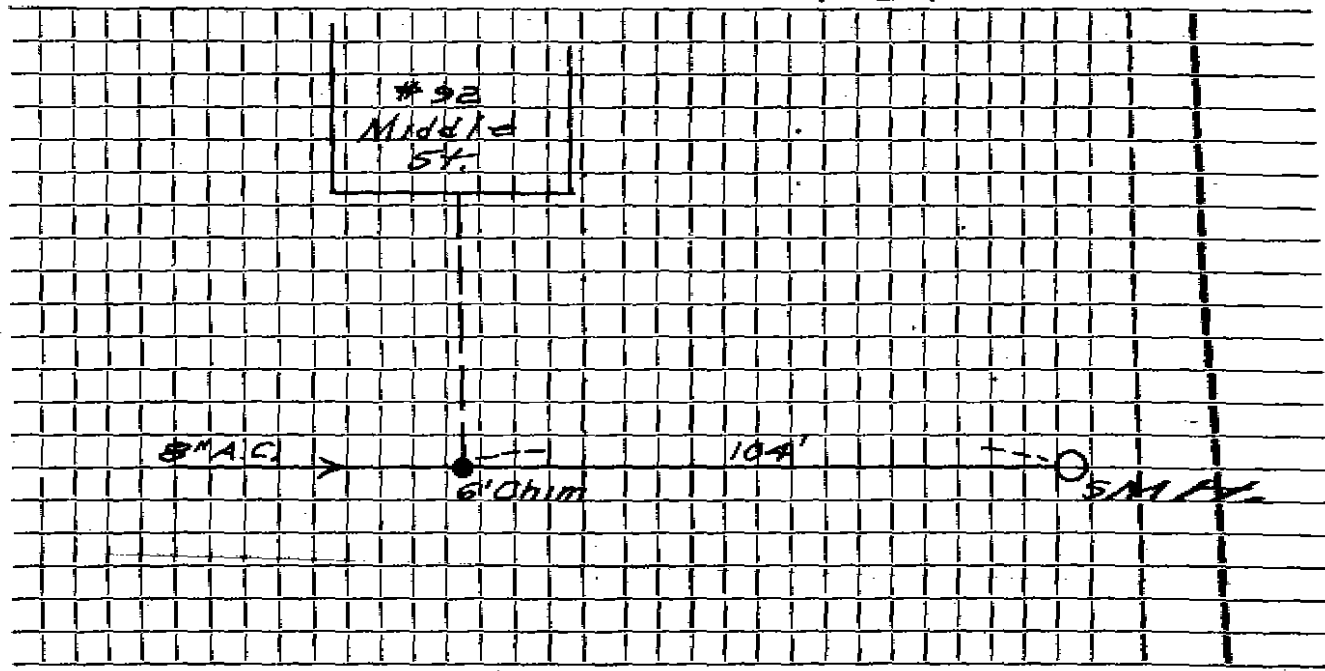

Connection made in ..... Street. Work completed .....

Remarks: .....  
.....  
.....