

Name Richard Wansker

Service No. 10

Address 94 Middle Street

94 Middle ST.

Location

Kind of Pipe

Size 6"

Size of Main 8"

~~XXXXXXXXXXXX~~—New Service

Location Comm 5-8-61


Date	Material	Amount	Total	Date	Amount
3-23-61	Labor	76.73		3-22-61	Deposit 150.00
4-7-61	"	16.18	92.91	5-17-61	Paid 52.82
	10% O.H.	9.29	102.20		202.82
	45' 6" Transite pipe @.78		35.10		
	15 ton Bank Gravel @.85		12.75		
	1 11 $\frac{1}{2}$ " Transite Elbow		2.27		
	1 11 $\frac{1}{2}$ " Transite Bend		5.10		
	1 6" Transite 90° Elbow		5.40		
	15 x 3 Patch		15.00		
	2 hrs. Town Shovel @6.50		13.00		
	3 hrs. Trucking @3.00		9.00		
	1 hr. Loader @3.00		3.00		
			202.82		

DATE \_\_\_\_\_

TOWN OF LEXINGTON — BOARD OF PUBLIC WORKS  
SEWER DIVISION

Sketch of Service Here

94

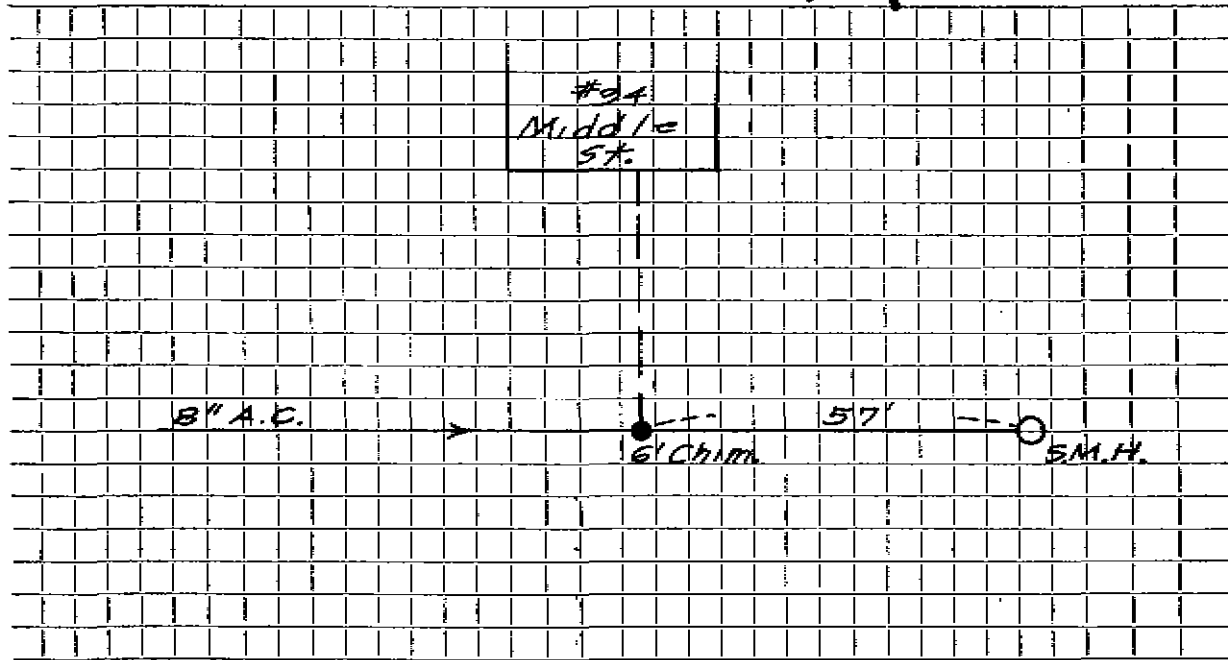

Connection made in ..... Street. Work completed .....

Remarks: .....

.....

.....