

Name

Address

11 Middleby Rd.

Location

Kind of Pipe

Size 6"

Size of Main 10"

Repair—Renewal—New Service


Location

Date	Material	Amount	Total	Date	Amount
1-63					
59' 6"	TRANSITE				
1 6"	90° Elbow				
1 6" X 10"	wye				

DATE _____

TOWN OF LEXINGTON — BOARD OF PUBLIC WORKS
SEWER DIVISION

Sketch of Service Here **11**

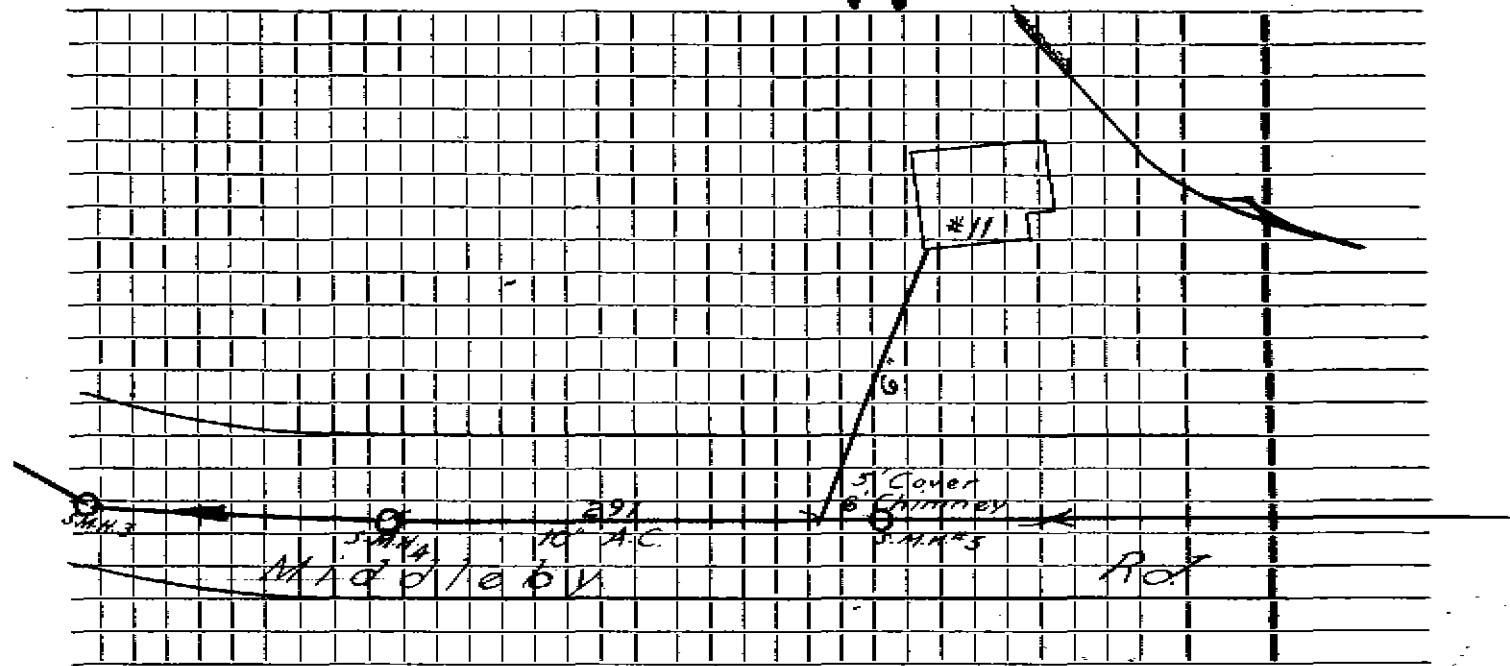

Connection made in Street. Work completed

Remarks:
.....
.....