

Name Custom Colonials Inc.

Service No. 52

Address 15 Middleby Road

15 Middleby Rd.

Location

Kind of Pipe

Size 6"

Size of Main 10"

~~Repair~~ New Service W.O.#7979

Location Comm. 10-28-63

Date	Material	Amount	Total	Date	Amount
6-63	Labor	91.72		5-22-63	250.00
	10% O.H.	9.17	100.89	10-28-63	28.00
	62' 6" Transite pipe @.82		50.84		222.00
	3 22 $\frac{1}{2}$ " Transite Bends @4.09		12.27		NON CHARGE
	6 hrs. Town Shovel @6.50		39.00	6-7-63	53.19
	3 hrs. Trucking @3.00		9.00		
	10 x 3 Patch		10.00		
			222.00		


DATE _____

TOWN OF LEXINGTON — BOARD OF PUBLIC WORKS

SEWER DIVISION

Sketch of Service Here

15

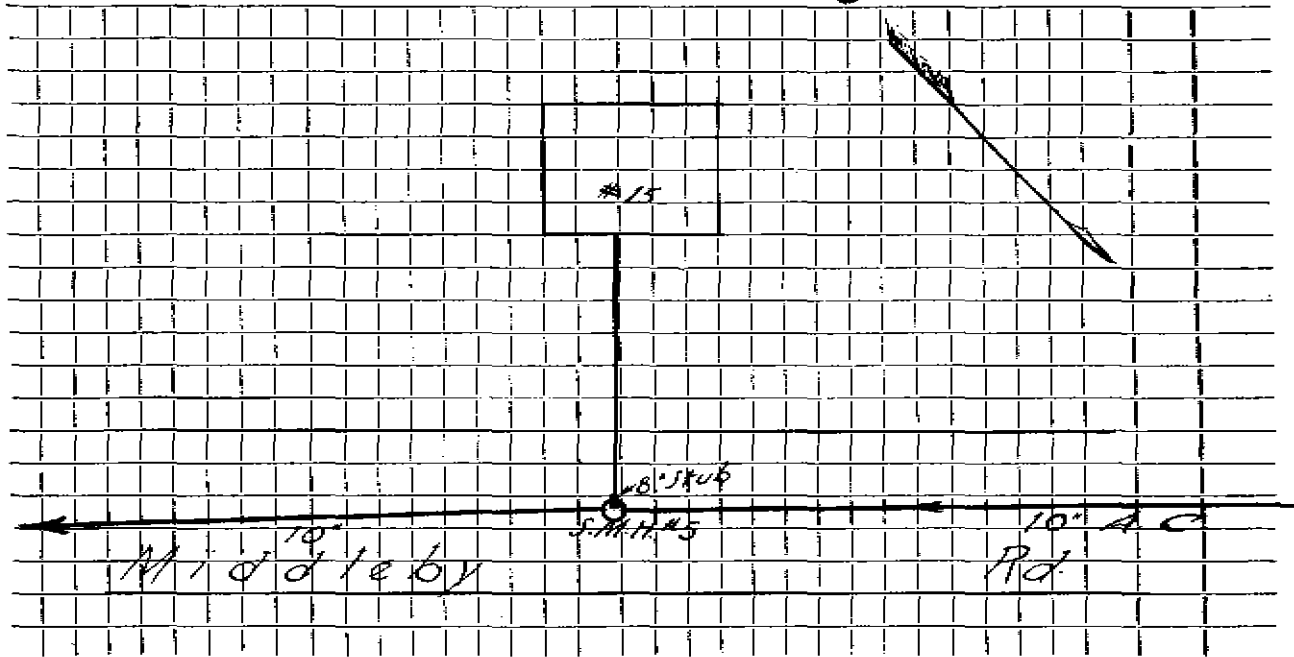

Connection made in Street. Work completed

Remarks: ..SEWER... goes To... Man Hole.....