

Name

Service No.

Address

16 Midd Leby Rd.

Location

Kind of Pipe

Size 6"

Size of Main 10"

Repair—Renewal—New Service

Location

Date	Material	Amount	Total	Date	Amount
13-61					
72'	72" TRANSITE				
1	6" - 90° ELBOW				
1	6" - 22 1/2 Bend				


DATE _____

TOWN OF LEXINGTON — BOARD OF PUBLIC WORKS

SEWER DIVISION

Sketch of Service Here

16

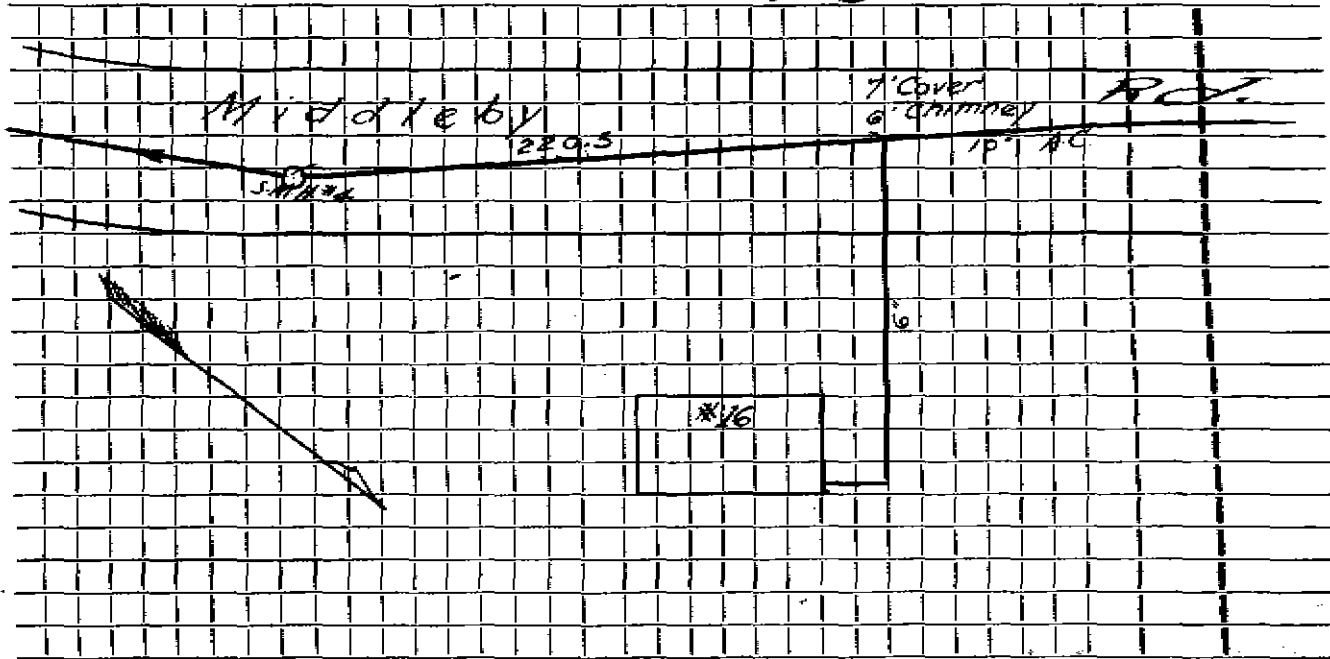

Connection made in Street. Work completed

Remarks:

.....

.....