

Name **Harley Hansen**

Service No.

Address **19 Middleby Road****19 Middleby Rd.**

Location

Kind of Pipe

Size **6"**Size of Main **10"**Repair—Renewal—New Service **W.O. #8672**Location **Comm 9-21-69**


Date	Material	Amount	Total	Date	Amount
1/64	labor	97.50		4-21-64	Deposit 225.00
	10% O.H.	9.75	107.25	9-29-64	Paid 3.28
60'	6" Transite pipe @ .82		49.20		228.28
1	Bag Cement		1.50		
1	12" Nipple		1.21		
1	90° Transite Elbow		4.09		
2	22½° Transite Bends @ 4.09		8.18		
5	yds. loam @ 3.00		15.00	6/5/95	Had Service Roded Out
	Lime & Fertilizer		1.85		Roots Sidewalk Area
	15 x 3 Patch		15.00		Respond & Measure (J.W.)
2	hrs. Town Shovel @ \$6.50		13.00		
3	hrs. Trucking @ \$3.00		9.00	11/14/95	Repair Made (C.F.)
1	hr. Trailer @ \$3.00		3.00		4½' 6" PVC
			228.28	1	6" Y
				1	6" Cap
				2	6" AC to PVC Fernco

DATE _____

TOWN OF LEXINGTON — BOARD OF PUBLIC WORKS
SEWER DIVISION

Sketch of Service Here

19

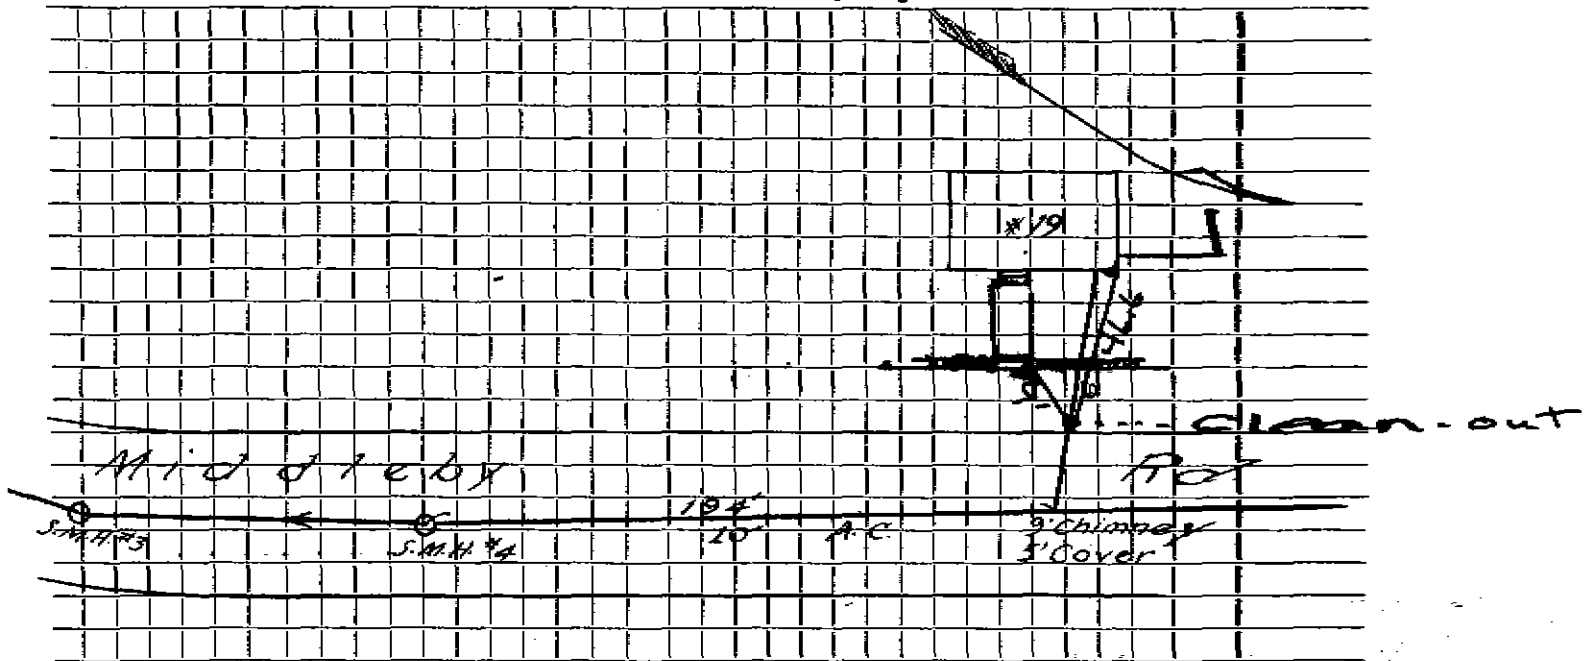

Connection made in Street. Work completed

Remarks: Clean out installed 11-14-95 Just below service marked with
and Curb Rods.....