

Name **William Atamian**

Service No. 19

Address **25 Middleby Road**

25 Middleby Rd.

Location

Kind of Pipe

Size **6"**

Size of Main **10"**

~~Repair~~ **New Service** NO #7113

Location **Comm 6-25-62**


Date	Material	Amount	Total	Date	Amount
1/62	Labor	87.01		4-4-62	250.00
1/62	"	15.90	102.91	6-25-62	19.15
	10% O.H.	10.29	113.20		230.85
60'	Transite Pipe @ .78		46.80		
1	11 $\frac{1}{2}$ $^{\circ}$ Transite Elbow		2.24		
1	22 $\frac{1}{2}$ $^{\circ}$ Transite Bend		6.21		
1	90 $^{\circ}$ Transite Elbow		5.40		
3	Ton 3/4" Stone @ 1/50		4.50		
	15 x 3 Patch		15.00		
3	hrs. Tom Shovel @ 6.50		19.50		
4	hrs. Trucking @ 3.00		12.00		
1	hr. Trailer @ 3.00		3.00		
1	hr. Loader @ 3.00		3.00		
			230.85		
				3-22-65	Reqs
				1-6-76	Salids
				11-20-84	Reqs 3' from base bed joint 95' out

DATE _____

TOWN OF LEXINGTON — BOARD OF PUBLIC WORKS

SEWER DIVISION

Sketch of Service Here **25**

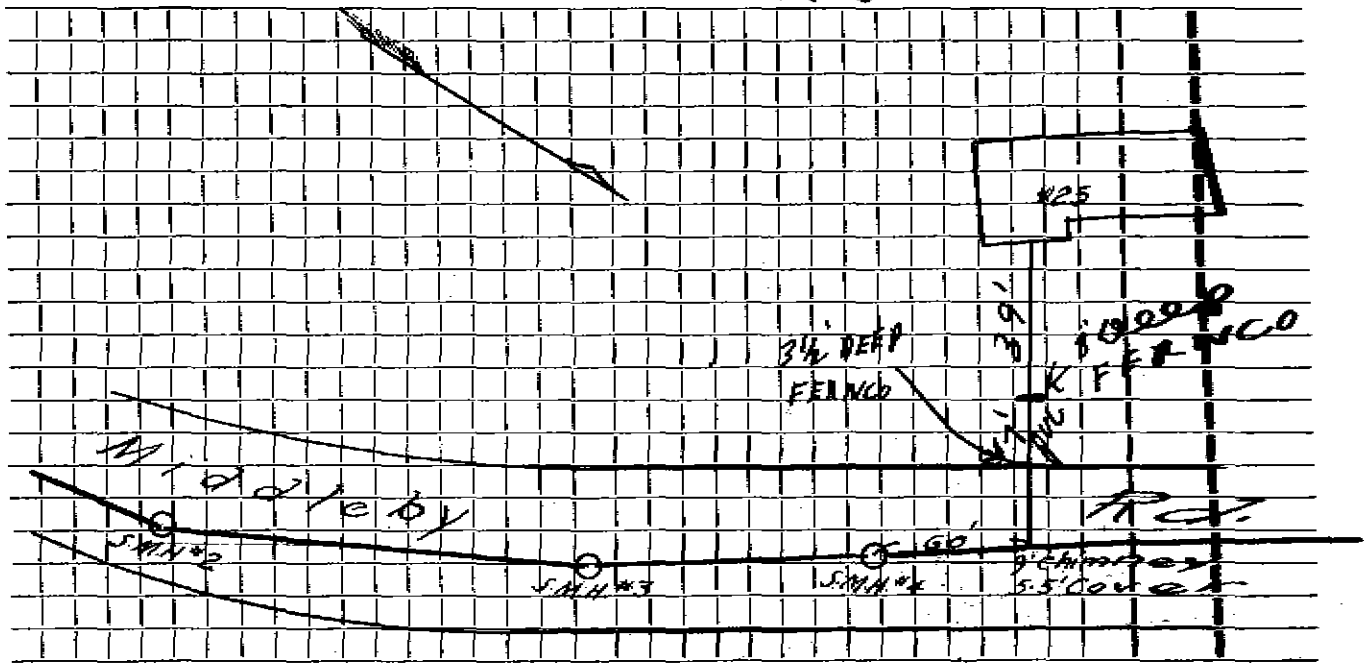

Connection made in Street. Work completed

Remarks:
.....
.....