

Name

Service No.

Address

28 Midd Leby Rd.

Location

Kind of Pipe

Size 6"

Size of Main / 0"

Repair—Renewal—New Service

Location

Date	Material	Amount	Total	Date	Amount
4-1-61	6" Transite				
1	6" - 90° Elbow				


DATE \_\_\_\_\_

# TOWN OF LEXINGTON — BOARD OF PUBLIC WORKS

## SEWER DIVISION

Sketch of Service Here

28

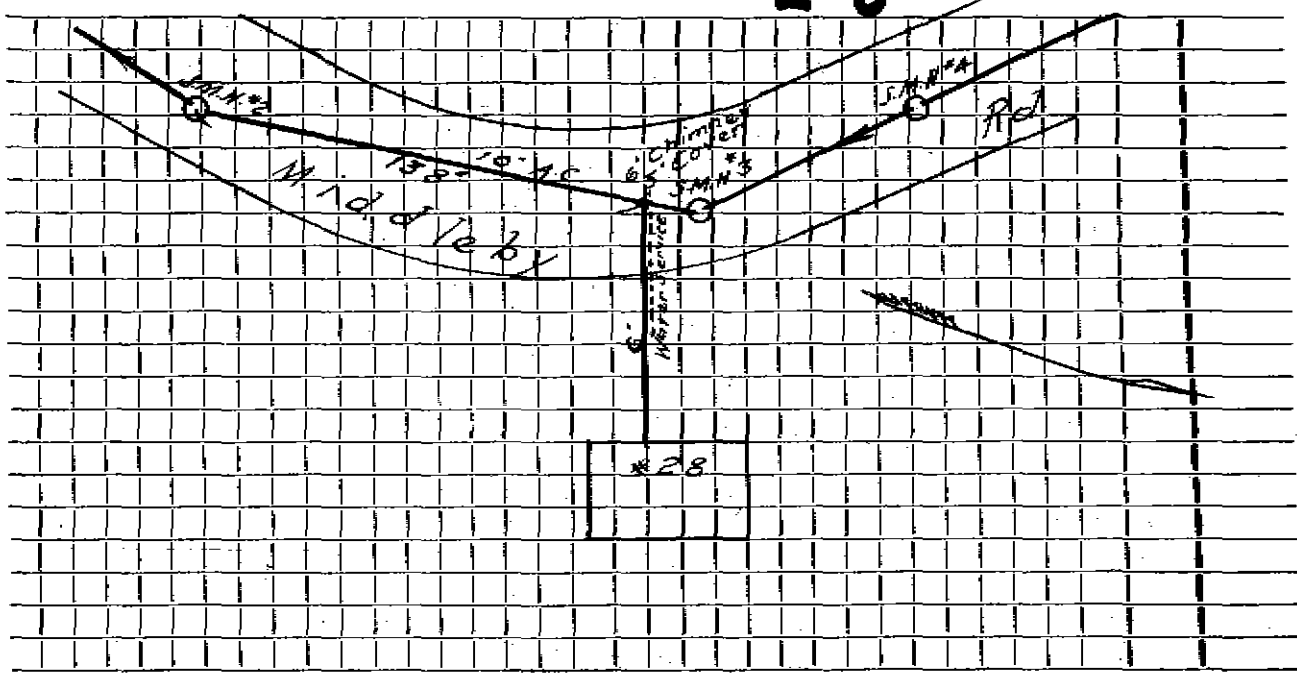

Connection made in ..... Street. Work completed .....

Remarks: .....  
.....  
.....