

Name **Alexander Nahigian**

Service No. 202

Address **31 Middleby Road**

31 Midd laby Rd.

Location

Kind of Pipe

Size **6"**

Size of Main **10"**

~~Revised~~ **New Service Suburbanite Cesspool Permit #A56 W.O.#1171**


Location **MAR 14 1966**

Date	Material	Amount	Total	Date	Amount
-15-65	Labor	104 92		11-25-65	125 00
	10% O.H.	10 49	115 41	12-8-65	79 61
35'	6" Transite pipe @ .82		28 70		204 61
	22 x 3 Patch		22 00		
2	Hrs Town Truck @ 3.00		6 00		
5	Hrs Tractor @ 6.50		32 50		
			204 61		
-65	32' 6" Transite pipe				
					Bill sent 79.61

DATE _____

TOWN OF LEXINGTON — BOARD OF PUBLIC WORKS
SEWER DIVISION

Sketch of Service Here **31**

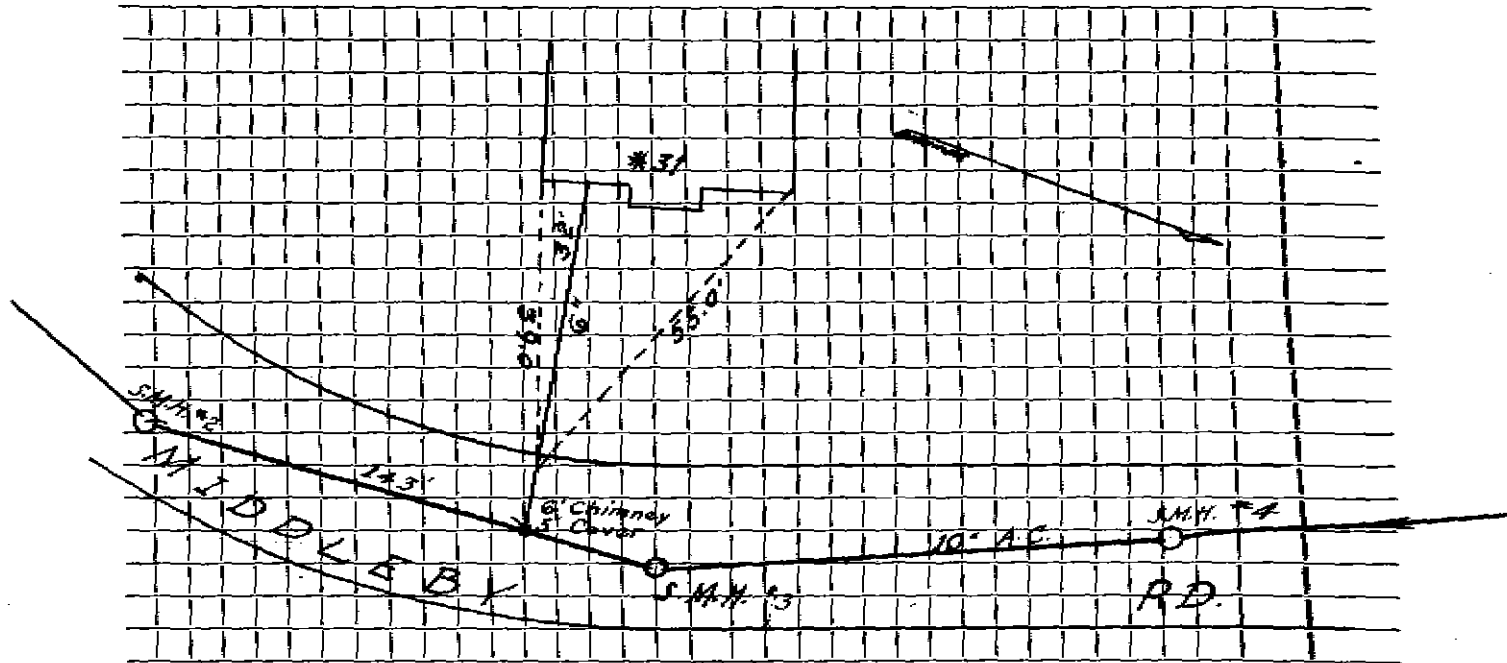

Connection made in Street. Work completed

Remarks:
.....
.....