

Name James E. Brown

Service No. 192

Address 34 Middleby Road

34 Middleby Rd.

Location

Kind of Pipe

Size 6"

Size of Main 10"

~~REMOVED~~ New Service Suburbanite Cesspool Permit #A-41 W.O.#1112

Location

MAR 14 1966


Date	Material	Amount	Total	Date	Amount	
25-65	Labor	105 37		10-14-65	Deposit	100 00
	10% O.H.	10 54	115 91	4-8-64	Paid	67 97
<del>16'</del>	<del>6" Transite pipe @ .82</del>		13 12	10-25-65		167 97
1	90° Elbow		1 09		16' 6" Transite	
1/2	Bag Cement @ 1.50		75		1 6"-90° Elbow	
	8 x 3 Patch		8 00			
2	Sticks Dynamite @ .27		54			
2	Caps @ .28		56			
2	Hrs. Shovel @ 6.50		13 00		Teardown	
1	Hr. Loader		4 00			
1	Hr. Compressor		5 00		New House Hasn't	
1	Hr. Town Truck		3 00		Been Built Yet	
			167 97		10-29-99	JMR
25-65	17' 6" Transite pipe				Bill sent 6797	

DATE \_\_\_\_\_

TOWN OF LEXINGTON — BOARD OF PUBLIC WORKS

SEWER DIVISION

Sketch of Service Here **34**

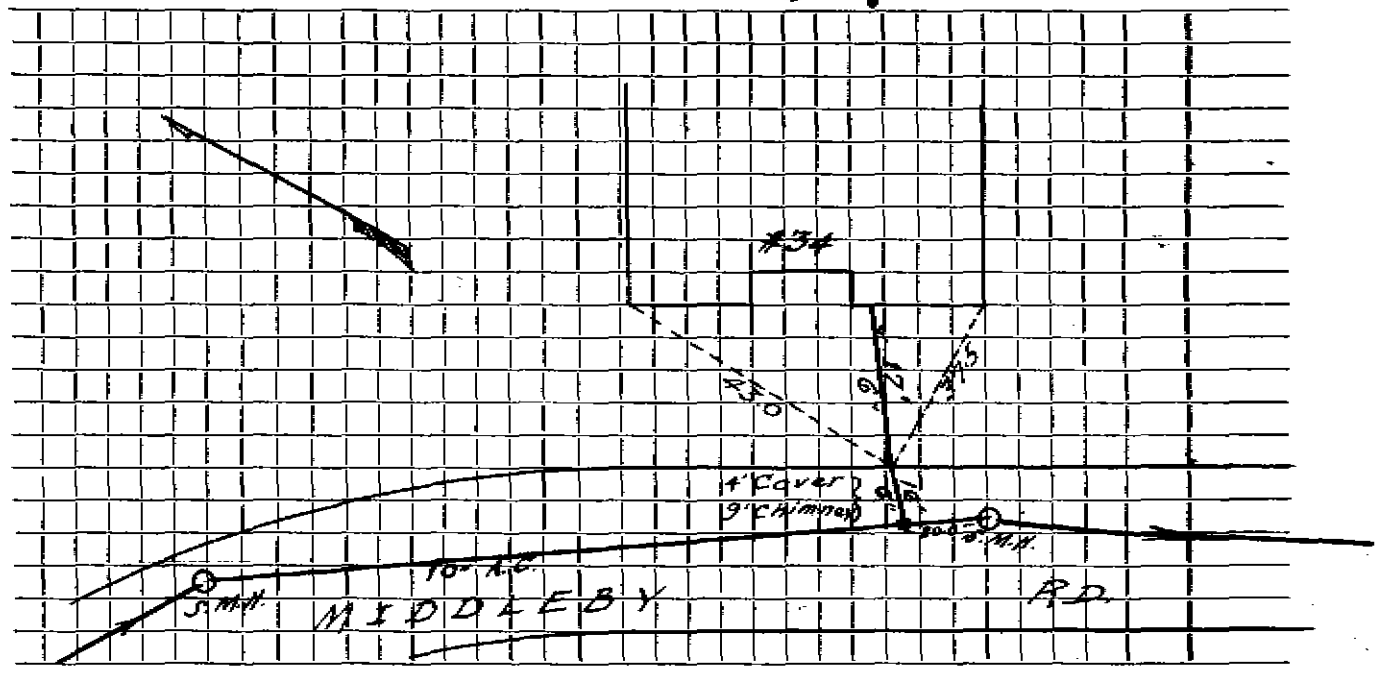

Connection made in ..... Street. Work completed .....

Remarks: .....  
.....  
.....